

BOARD OF WATER COMMISSIONERS

416 North State Street
Jackson, Mississippi 39201

Wayne

WATER WELL DRILLERS LOG

B 18
11-6-72

Nov. 6 1972 Porter Drilling & Log Wayne
date well completed firm name county well located

LANDOWNER: O. D. Barnett

description of formations encountered	from	to
red clay	0	15
sand	15	80
sand iron gravel	80	112

At 1 Shubuta Miss
(mailing address)

WELL LOCATION:
sec 23 T 10 (N) R 8 (E) S (W)
9 miles N.W of Waynesboro
(distance) (direction) (nearest town)

stone well with
shell in sand
& pea gravel

WELL PURPOSE: home
(home, irrigation, municipal, industrial)

5' 1 1/2" 6 slot S.S.

WELL COMPLETION DATA:

- (1) diameter (inches) 2"
- (2) total depth (feet) 112'
- (3) static water level (feet) 85 (below/above top of ground)
- (4) casing steel 107'
(material) (depth)
2" if telescope see back.
(size)
- (5) screen 5' 107'
(length) (depth to top)
1/4" 6 slot S.S.
(size) (material)
- (6) pump 1 1/2 10
(HP) (yield gpm)
elec
(type power)
- (7) electric log no
(yes or no)

screwed on casing
with back wash
valve on end
94' 1 1/4" drop pipe

(organization running log)

(8) how well bottom plugged?
flush


NOV 20 1972

DRILLERS REMARKS:

MISSISSIPPI BOARD OF WATER COMMISSIONERS

If well telescopes please sketch and show depths.

GROUND LEVEL

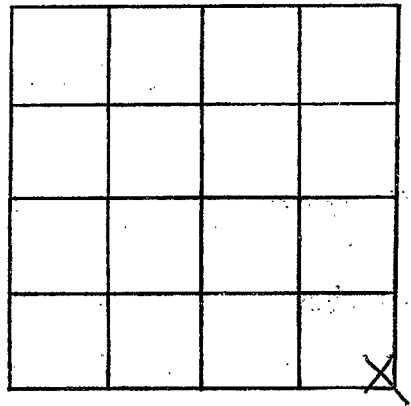

SECTION 33

Please indicate well location X.

ADDITIONAL INFORMATION

Lined area for additional information.

If more than one screen, show locations of each on sketch.