

**WAYNE**  
**B 19**  
**11-12-73**

MISSISSIPPI  
 BOARD OF WATER COMMISSIONERS  
 416 North State Street  
 Jackson, Mississippi 39201

**CODEN**

**WATER WELL DRILLERS LOG**

**McILWAIN WATER WELL SERVICE WAYNE**

Nov 12, 1973 19  
 date well completed

RT. 4 BOX 37

county well located


WAYNESBORO, MISS. 39362

LANDOWNER:	description of formations encountered	from	to
MARSHALL FALCONER	RED CLAY + SAND	0	35
RT 1 SHUBUTTA, MISS (mailing address)	WHITE SAND	35	50
WELL LOCATION: sec. 26 T 10 N R 3 W 14 miles NW of W'BOURD (distance) (direction) (nearest town)	COARSE SAND AND PEA GRAVEL	50	55
WELL PURPOSE: HOME (home, irrigation, municipal, industrial)	CLAY	55	78
WELL COMPLETION DATA: (1) diameter (inches) 2" (2) total depth (feet) 122' (3) static water level (feet) 58 below top of ground. (4) casing PVC 112' (material) (depth) 2" (size) if telescope see back. (5) screen 10' 112' (length) (depth to top) 2" .008 (size) (material) (6) pump 1 (HP) 9 (yield gpm) 110 AC (type power) (7) electric log NO (yes or no) (organization running log) (8) how well bottom plugged	FINE SAND AND CLAY STREAKS	78	88
	CLAY	88	94
	FINE SAND	94	105
	CLAY	105	112
	COARSE HARD SAND	112	122
DRILLERS REMARKS:			

DEC - 7 1973

If well telescopes please sketch and show depths.

GROUND LEVEL

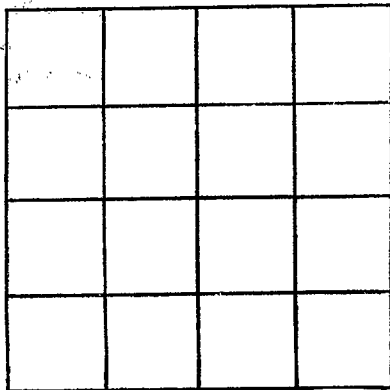

SECTION \_\_\_\_\_

Please indicate well location X.

ADDITIONAL INFORMATION

If more than one screen,  
show locations of each on sketch.