

WAYNE
B 20
12-15-73

MISSISSIPPI
BOARD OF WATER COMMISSIONERS
416 North State Street
Jackson, Mississippi 39201

CODED

WATER WELL DRILLERS LOG

12-15-73 date well completed
J. J. Hester Waterwell Drill Wayne firm name
Wayne county well located

LANDOWNER:

Mrs. Almada Carter
R. 3 Box 138 Shubuta Miss
(mailing address) 39360

description of formations
encountered

from to

Red Clay	0	10
Sand	10	20
WHITE "	20	30
"	30	40
"	40	50
"	50	60
"	60	70
"	70	74
Yellow Chalk	74	78
Rock	78	80
"	80	82
Blue Chalk	82	90
"	90	91
Rock	91	93
Coarse Sand	93	99
Chalk	99	

WELL LOCATION:

sec. 18 T. 10 N. R. 8 E.
10 miles west of Shubuta
(distance) (direction) (nearest town)

WELL PURPOSE:

(home, irrigation, municipal, industrial)

WELL COMPLETION DATA:


- diameter (inches) 4"
- total depth (feet) 99'
- static water level (feet) 77' below top of ground.
- casing PVC, 94' (material) (depth)
(size) if telescope see back.
- screen 5' 94' (length) (depth to top)
2" 008 PVC (size) (material)
- pump 1 HP 5 (HP) (yield gpm)
110 V AC (type power)
- electric log No (yes or no)
(organization running log)
- how well bottom plugged

DRILLERS REMARKS:

MISS. Bd. of
WATER COMMISSIONERS

If well telescopes please
sketch and show depths.

GROUND LEVEL

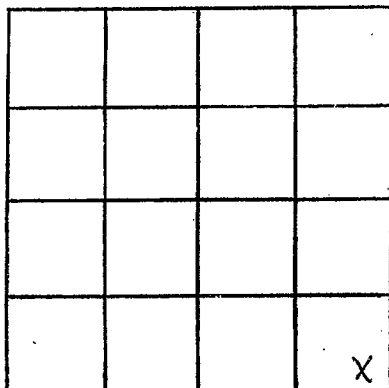

SKETCH SE $\frac{1}{4}$

SECTION

18

Please indicate well location X.

ADDITIONAL INFORMATION

If more than one screen,
show locations of each on sketch.