

**WAYNE**  
**B 21**  
**1-25-74**

MISSISSIPPI  
 BOARD OF WATER COMMISSIONERS  
 416 North State Street  
 Jackson, Mississippi 39201

**CODED**

**WATER WELL DRILLERS LOG**

**McILWAIN WATER WELL SERVICE** *Wayne*

*JAN 25, 1974*  
 date well completed

Rt. 4, Box 31

county well located

**WAYNESBORO, MISS. 39367**


LANDOWNER:	description of formations encountered	from	to
<i>Julius McCall</i>	<i>Red Sand</i>	<i>0</i>	<i>35</i>
<i>Rt 1, SHUBUTTA, Miss.</i> (mailing address)	<i>white Sand, some clay</i>	<i>35</i>	<i>55</i>
WELL LOCATION: sec. <i>26</i> T. <i>10</i> N R. <i>8</i> E <i>13</i> miles <i>NW</i> of <i>W'boro</i> (distance) (direction) (nearest town)	<i>Clay</i>	<i>55</i>	<i>85</i>
WELL PURPOSE: <i>HOME</i> (home, irrigation, municipal, industrial)	<i>med. sand</i>	<i>85</i>	<i>92</i>
WELL COMPLETION DATA: (1) diameter (inches) <i>2"</i>	<i>clay</i>	<i>92</i>	<i>93</i>
(2) total depth (feet) <i>106'</i>	<i>med coarse sand</i>	<i>93</i>	<i>106</i>
(3) static water level (feet) <i>71'</i> below top of ground.			
(4) casing <i>PVC</i> , <i>96'</i> (material) (depth) <i>2"</i> if telescope see back. (size)			
(5) screen <i>10'</i> , <i>96'</i> (length) (depth to top) <i>2"</i> , <i>PVC .008</i> (size) (material)			
(6) pump <i>1</i> , <i>8</i> (HP) (yield gpm) <i>110 AC</i> (type power)			
(7) electric log <i>No</i> (yes or no)  (organization running log)			
(8) how well bottom plugged			
DRILLERS REMARKS:			

**CODED**

RECEIVED  
 FEB 13 1974  
 MISSISSIPPI BOARD OF WATER COMMISSIONERS

If well telescopes please sketch and show depths.

GROUND LEVEL

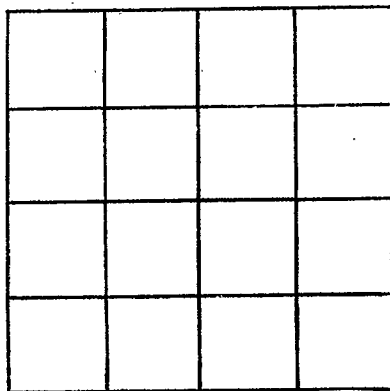

SECTION \_\_\_\_\_

Please indicate well location X.

ADDITIONAL INFORMATION

If more than one screen, show locations of each on sketch.