

WAYNE
B23
4-23-74

MISSISSIPPI
 BOARD OF WATER COMMISSIONERS
 416 North State Street
 Jackson, Mississippi 39201

CODED

WATER WELL DRILLERS LOG

McILWAIN WATER WELL SERVICE WAYNE

APR 23, 1974
 date well completed

RT. 2 BOX 37

county well located

WAYNESBORO, MISS. 39367

LANDOWNER:
S. T. BROWN
WAYNESBORO, MISS.
 (mailing address)

description of formations encountered	from	to
RED CLAY	0	10
SAND	10	16
SAND + CLAY STREAKS	16	28
SAND	28	32

WELL LOCATION:
 sec 35 T 10 N R 8
6 miles E of Evcutta
 (distance) (direction) (nearest town)


WELL PURPOSE: STORE
 (home, irrigation, municipal, industrial)

- WELL COMPLETION DATA:**
- (1) diameter (inches) 2"
 - (2) total depth (feet) 32'
 - (3) static water level (feet) 6' below top of ground.
 - (4) casing PVC, 27'
 (material) (depth)
2" If telescope see back.
 (size)
 - (5) screen 5', 27'
 (length) (depth to top)
2", PVC .010
 (size) (material)
 - (6) pump 1, 8
 (HP) (yield gpm)
120 AC
 (type power)
 - (7) electric log NO
 (yes or no)
- (organization running log)

CODED

(8) how well bottom plugged


DRILLERS REMARKS:

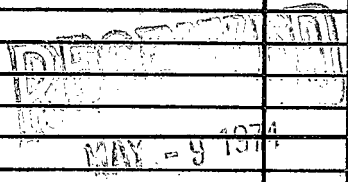

MISS. Bd. OF WATER COMM.

If well telescopes please sketch and show depths.

GROUND LEVEL

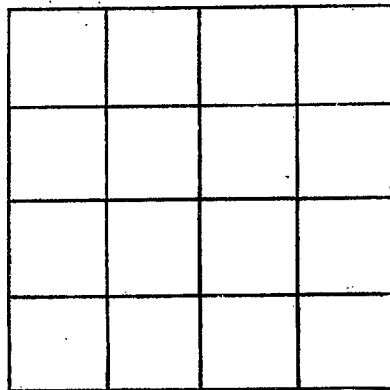

SECTION _____

Please indicate well location X.

ADDITIONAL INFORMATION

If more than one screen,
show locations of each on sketch.