

WAYNE
B 24
4-1-74

MISSISSIPPI
BOARD OF WATER COMMISSIONERS
416 North State Street
Jackson, Mississippi 39201

WATER WELL DRILLERS LOG

April 1 1974 Booth Drilling Wayne
date well completed firm name county well located

LANDOWNER: Don Gallen

description of formations encountered

from to

Box 1 Shubuta
(mailing address)

<u>rest of clay</u>	<u>0</u>	<u>6</u>
<u>clay</u>	<u>6</u>	<u>27</u>
<u>Chalk</u>	<u>27</u>	<u>28</u>
<u>clay</u>	<u>28</u>	<u>46</u>
<u>clay</u>	<u>46</u>	<u>47</u>
<u>Chalk</u>	<u>47</u>	<u>48</u>

WELL LOCATION:

sec. 34 T. 10 N. R. 3 E. W. W
11 miles NW of Waynesboro
(distance) (direction) (nearest town)

WELL PURPOSE: none
(home, irrigation, municipal, industrial)

39' 1" P.V.C. drop pipe

WELL COMPLETION DATA:

- (1) diameter (inches) 2"
- (2) total depth (feet) 46'
- (3) static water level (feet) 24 below top of ground. above
- (4) casing PVC, 41',
(material) (depth)
2',
(size) if telescope see back.
- (5) screen 5', 41'
(length) (depth to top)
2", 102' 1" P.V.C.
(size) (material)
- (6) pump 1.5
(HP) (yield gpm)
elec.
(type power)
- (7) electric log no
(yes or no)

(organization running log)


(8) how well bottom plugged back wash valve

DRILLERS REMARKS:

APR 2 1974

If well telescopes please
sketch and show depths.

GROUND LEVEL

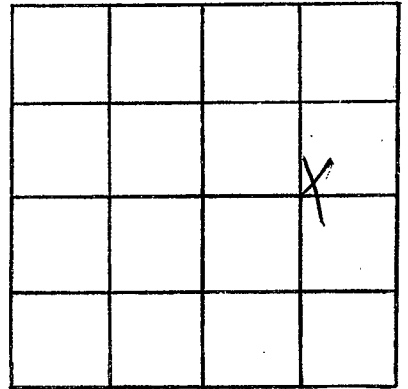

SECTION 34

Please indicate well location X.

ADDITIONAL INFORMATION

If more than one screen,
show locations of each on sketch.