

WAYNE  
B25  
FI-75

MISSISSIPPI  
BOARD OF WATER COMMISSIONERS

416 North State Street

Jackson, Mississippi 39201

CODED

WATER WELL DRILLERS LOG

Jan 1  
date well completed

1975 Routh Drilling & Log  
firm name

Wayne  
county well located

LANDOWNER: Mrs Ralph

Waller

description of formations encountered

from

to

At 1 Shubuta Miss  
(mailing address)

red clay 0 17  
sand shale  
open gravel & chalk 17 128  
light blue white shell  
in sand

WELL LOCATION:

sec. 35 T 10 N R 8 E 13P  
8 miles NW of Waynesboro  
(distance) (direction) (nearest town)

WELL PURPOSE: Drill  
(home, irrigation, municipal, industrial)

WELL COMPLETION DATA:

- (1) diameter (inches) 2"
- (2) total depth (feet) 128'
- (3) static water level (feet) 94' below/above top of ground.
- (4) casing PVC 123'  
(material) (depth)  
2"  
(size) if telescope see back.
- (5) screen 5' 123'  
(length) (depth to top)  
1 1/4" galv S.S.  
(size) (material)
- (6) pump 1 1/2 7  
(HP) (yield gpm)  
elec  
(type power)
- (7) electric log no  
(yes or no)

5' galv screen  
on end of casing with  
brake & bush rubber on end  
and shell top above

102' 1" PVC drop  
pipe

(organization running log)

(8) how well bottom plugged  
back wash valve


DRILLERS REMARKS:

RECEIVED  
MAR 3 1975

MISS. BD. OF WATER COMMISSIONERS

If well telescopes please sketch and show depths.

GROUND LEVEL

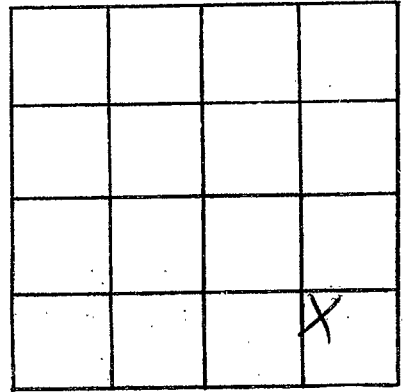

SECTION 35

Please indicate well location X.

ADDITIONAL INFORMATION

If more than one screen,  
show locations of each on sketch.