

WAYNE  
B 26  
2-3-75

MISSISSIPPI  
BOARD OF WATER COMMISSIONERS  
416 North State Street  
Jackson, Mississippi 39201

CODED

WATER WELL DRILLERS LOG

McILWAIN WATER WELL SERVICE

Feb 3, 1975  
date well completed

RT. 2 BOX 37

WAYNESBORO, MISS. 39367

WAYNE

county well located


LANDOWNER:	description of formations encountered	from	to
GARY GATLIN	Red sand + clay	0	5
RT 1 SHUBUTTA, Miss (mailing address)	Sand + gravel	5	40
WELL LOCATION:	Blue Clay	40	55
sec. 34 T 10 N R 8 E 13 P	Rock	55	56
6 miles E of EUCUTHA (distance) (direction) (nearest town)	Clay + Rock	56	75
WELL PURPOSE: FARM (home, irrigation, municipal, industrial)	Clay	75	109
WELL COMPLETION DATA:	Rock	109	112
(1) diameter (inches) 2"	Honeycomb Rock	112	150
(2) total depth (feet) 150'			
(3) static water level (feet) 65' below top of ground.			
(4) casing PVC, 122' (material) (depth)			
2" if telescope see back. (size)			
(5) screen NONE (length) (depth to top)			
(size) (material)			
(6) pump 1 1/2 HP 8 (HP) (yield gpm)			
220 (type power)			
(7) electric log NO (yes or no)			
(organization running log)			
(8) how well bottom plugged			
DRILLERS REMARKS:			

CODED

RECEIVED  
MAR - 5 1975  
MISS. DEPT. OF...

If well telescopes please sketch and show depths.

GROUND LEVEL

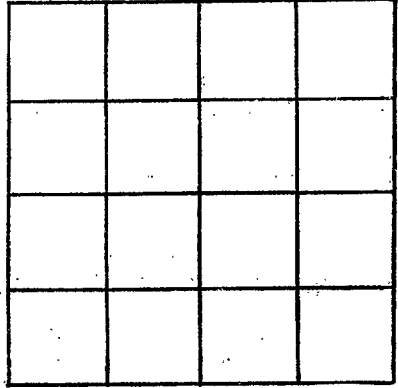

SECTION \_\_\_\_\_

Please indicate well location X.

ADDITIONAL INFORMATION

If more than one screen, show locations of each on sketch.