

Wayne
 B 27
 6-3-75

MISSISSIPPI
 BOARD OF WATER COMMISSIONERS CODED
 416 North State Street
 Jackson, Mississippi 39201

WATER WELL DRILLERS LOG

McILWAIN WATER WELL SERVICE

June 3, 1975
 date well completed

RT. 2 BOX 27
 WAYNESBORO, MISS. 39367

Wayne
 county well located

LANDOWNER:
 Mr. Curt Daniels
 Waynesboro, Miss.
 (mailing address)

description of formations encountered	from	to
Red Clay	0	8
Red sand	8	18
clay	18	20
sand + clay	20	25
sand	25	45

WELL LOCATION:
 sec. 35 T. 10 N R. 8 E 13P
 12 miles NW of W'BORO
 (distance) (direction) (nearest town)

WELL PURPOSE: HOME
 (home, irrigation, municipal, industrial)

- WELL COMPLETION DATA:
- (1) diameter (inches) 2"
 - (2) total depth (feet) 45'
 - (3) static water level (feet) 18' below top of ground.
 - (4) casing PVC 40'
 (material) (depth)
 2" (size) if telescope see back.
 - (5) screen 5' 40'
 (length) (depth to top)
 2" PVC 008 slot
 (size) (material)
 - (6) pump 1 12
 (HP) (yield gpm)
 220 AC
 (type power)
 - (7) electric log no
 (yes or no)
 - (organization running log)
 - (8) how well bottom plugged


DRILLERS REMARKS:

RECEIVED
 JUN 18 1975

MISS. BD. OF WATER COM.

If well telescopes please sketch and show depths.

GROUND LEVEL

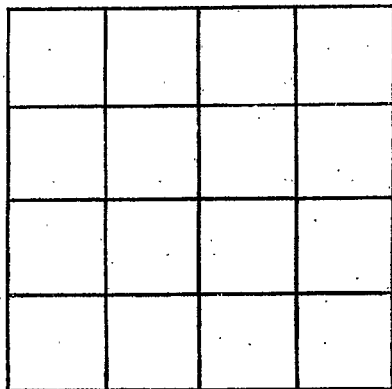

SECTION _____

Please indicate well location X.

ADDITIONAL INFORMATION

If more than one screen, show locations of each on sketch.