

Wayne
B 29
6-75

MISSISSIPPI
BOARD OF WATER COMMISSIONERS
416 North State Street
Jackson, Mississippi 39201

CODED

WATER WELL DRILLERS LOG

June 19 75 Peoples Drilling Co Wayne
date well completed firm name county well located


| LANDOWNER: | description of formations encountered | from | to |
|---|---------------------------------------|------|----|
| R. L. Cunningham | Red sandy clay | 0 | 18 |
| RFO 2 | Red sand | 18 | 37 |
| Shaluta, Miss (mailing address) | White clay | 37 | 44 |
| WELL LOCATION: NW SE sec. 34 T. 10 (N) S R. 8 E (W) | sand | 46 | 80 |
| 8 miles W of Hiram (distance) (direction) (nearest town) | | | |
| WELL PURPOSE: HOME (home, irrigation, municipal, industrial) | | | |
| WELL COMPLETION DATA: | | | |
| (1) diameter (inches) 2 | | | |
| (2) total depth (feet) 80 | | | |
| (3) static water level (feet) 55 below top of ground. | | | |
| (4) casing 75 (material) (depth) | | | |
| 2" (size) if telescope see back. | | | |
| (5) screen 5' (length) 75' (depth to top) | | | |
| 2 5/8" (size) PVC (material) | | | |
| (6) pump 1 (HP) 6 (yield gpm) | | | |
| Electric (type power) | | | |
| (7) electric log no (yes or no) | | | |
| (organization running log) | | | |
| (8) how well bottom plugged Back WASH valve | | | |
| DRILLERS REMARKS: | | | |

INSPECTED
KILGORE

SEP 15 1975

If well telescopes please sketch and show depths.

GROUND LEVEL

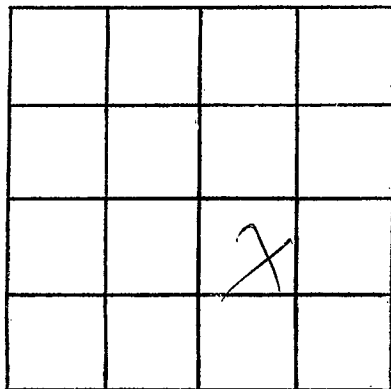

SECTION 34

Please indicate well location X.

ADDITIONAL INFORMATION

If more than one screen,
show locations of each on sketch.