

*Wayne*

B-31

MISSISSIPPI  
BOARD OF WATER COMMISSIONERS  
416 North State Street  
Jackson, Mississippi 39201

CODED

8/3/80

8-3-80

WATER WELL DRILLERS LOG

*Grimes Drilling Service, Inc.*

*Wayne*

date well completed

firm name

county well located

LANDOWNER:  
*V. Monte Currie, Jr.*  
*114 Jefferson Davis Blvd*  
*Natchez, MS 39120*  
(mailing address)

description of formations encountered

from

to

*Sand* 0 42  
*chalk + rock* 42 84

WELL LOCATION: *594' S + 738' W*  
*26 T 10 S R 8 E* of  
*Waynesboro*  
(distance) (direction) (nearest town)

*rock + chalk* 84 105  
*chalk + rock* 105 231

WELL PURPOSE: *oil field supply*  
(home, irrigation, municipal, industrial)

*chalk + rock* 231 357  
*chalk* 357 420

WELL COMPLETION DATA:

- (1) diameter (inches) 3"
- (2) total depth (feet) 588'
- (3) static water level (feet) 130' below top of ground
- (4) casing steel 525'  
(material) (depth)
- 3"  
(size) if telescope see back.
- (5) screen 42' 483'  
(length) (depth to top)
- 3" perforated  
(size) (material)
- (6) pump 1 70  
(HP) (yield gpm)
- ac  
(type power)
- (7) electric log —  
(yes or no)
- (organization running log)

*shell* 420 483  
*sand* 483 525  
*chalk* 525 588

CODED

(8) how well bottom plugged *orange peel*

DRILLERS REMARKS:


DEPT. OF NATURAL RESOURCES  
BUREAU OF LAND & WATER RESOURCES

AUG 27 1980

RECEIVED

If well telescopes please sketch and show depths.

GROUND LEVEL

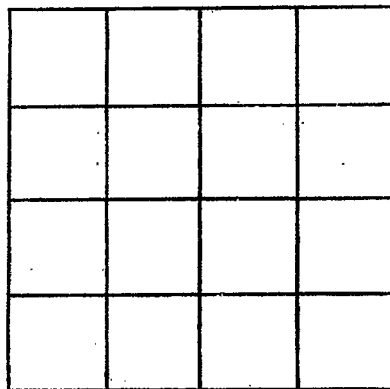

SECTION \_\_\_\_\_

Please indicate well location X.

ADDITIONAL INFORMATION

If more than one screen,  
show locations of each on sketch.