

Wayne  
B 33

MISSISSIPPI  
BOARD OF WATER COMMISSIONERS  
416 North State Street  
Jackson, Mississippi 39201

CODED

WATER WELL DRILLERS LOG

6-25-77

McILWAIN WATER WELL SERVICE

Wayne

date well completed

RT. 1 BOX 32

county well located

WAYNESBORO, MISS 39367

LANDOWNER:

description of formations encountered

from

to

Joy Daniels  
Rt 1 Schulista, Miss.  
(mailing address)

Red Sandy Clay	0	8
Red sand	8	12
White sand	12	18
Clay &	18	22
Sand	22	32

WELL LOCATION:

sec. 26 T. 10 N R. 8 W  
735  
7 miles E of Esculla  
(distance) (direction) (nearest town)

WELL PURPOSE: home  
(home, irrigation, municipal, industrial)

WELL COMPLETION DATA:

- (1) diameter (inches) 2"
- (2) total depth (feet) 32'
- (3) static water level (feet) 18' below above top of ground.
- (4) casing PVC 27'  
(material) (depth)  
2" if telescope see back.  
(size)
- (5) screen 5' 27'  
(length) (depth to top)  
2" PVC 508  
(size) (material)
- (6) pump 3/4 11  
(HP) (yield gpm)  
110 AC  
(type power)
- (7) electric log No  
(yes or no)

CODED

(organization running log)

(8) how well bottom plugged


DRILLERS REMARKS:

RECEIVED  
JUL 22 1977

MISS. BD. OF WATER COMMISSIONERS

If well telescopes please sketch and show depths.

GROUND LEVEL

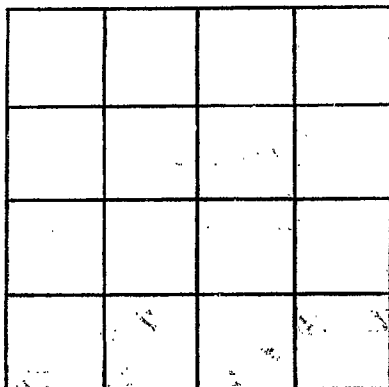

SECTION \_\_\_\_\_

Please indicate well location X.

ADDITIONAL INFORMATION

If more than one screen, show locations of each on sketch.