

MISSISSIPPI DEPARTMENT OF NATURAL RESOURCES

Bureau of Land and Water Resources

Southport Mall

P.O. Box 10631

Jackson, Mississippi 39209

WATER WELL DRILLERS LOG

CODED ✓

WAYNE

B 35

Elog # 315

4-29-82

4-29

19 32 RIVER DRILLING SER.

WAYNE

date well completed

firm name

county well located

LANDOWNER: H. WANNEE  
WATER ASSOC., WELL  
NO. 2  
 (mailing address)

WELL LOCATION: NW 1/4 SE 1/4 NW 1/4 SW 1/4  
 sec. 24 T. 10 N. R. 8 E. S. 1 W.

\_\_\_\_\_ miles \_\_\_\_\_ of \_\_\_\_\_  
 (distance) (direction) (nearest town)

WELL PURPOSE: RURAL WATER  
 (home, irrigation, municipal, industrial)

WELL COMPLETION DATA:

- (1) diameter (inches) 10 3/4
- (2) total depth (feet) 2779
- (3) static water level (feet) 103.5 below top of ground. 2-3-82 above
- (4) casing Steel (material), \_\_\_\_\_ (depth), 10 3/4 (size) If telescope see back.
- (5) screen 50 (length), 2727 (depth to top), 6" (size), 307 S.S. (10/16) (material)
- (6) pump 40 (HP), 413 (yield gpm), Elect. - 440 (type power)
- (7) electric log Yes (yes or no), MISS. Geol. Survey (organization running log)
- (8) how well bottom plugged BACK WAS VALVE & 5 FT. STINGER

description of formations encountered	from	to
Top soil	0	3
SAND & GRAVEL, Red	3	55
CLAY	55	90
LIME ROCK + VOIDS	90	170
CLAY	170	122
SAND + ROCKS	122	535
CLAY	535	600
SAND & CLAY STRAINS	600	850
CLAY + ROCKS	850	1090
SAND	1090	1060
CLAY + ROCKS	1060	1270
SAND	1270	1330
CLAY + ROCKS, Hard	1330	2565
SAND, fine	2565	2660
CLAY + ROCKS	2660	2730
SAND, COARSE	2730	2815

DEPT. OF NATURAL RESOURCES  
 BUREAU OF LAND & WATER RESOURCES

MAY - 3 1982


RECEIVED

DRILLERS REMARKS:

2

If well telescopes please sketch and show depths.

GROUND LEVEL

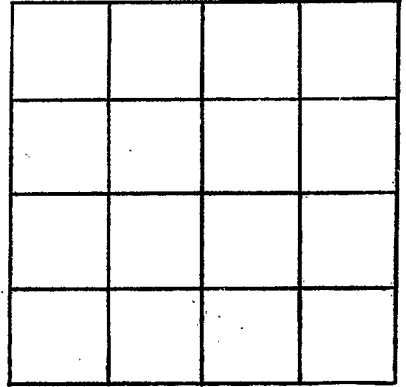

SECTION \_\_\_\_\_

Please indicate well location X.

ADDITIONAL INFORMATION

If more than one screen,  
show locations of each on sketch.