

WAYNE
B 2000
6-25-77

MISSISSIPPI
BOARD OF WATER COMMISSIONERS
416 North State Street
Jackson, Mississippi 39201

13P

WATER WELL DRILLERS LOG
MILWAIN WATER WELL SERVICE

Wayne

date well completed

RT. 2, Box 34
WAYNESBORO, MISS. 39367

county well located

LANDOWNER:
Ward Daniels
Schubuta Rt. 1, Miss.
(mailing address)

description of formations encountered	from	to
Red Clay	0	5
Sand	5	12
Clay	12	15
Sand	15	21
Sand & Clay	21	25
Med. Sand	25	39

WELL LOCATION:
sec. 26 T 10 N R 8 E
7 miles E of Eucuttia
(distance) (direction) (nearest town)

WELL PURPOSE: home
(home, irrigation, municipal, industrial)

WELL COMPLETION DATA:
(1) diameter (inches) 2"
(2) total depth (feet) 34'
(3) static water level (feet) 21' below top of ground.
(4) casing PVC 34' (material) (depth)
2" (size) If telescope see back.
(5) screen 5' 34' (length) (depth to top)
2" PVC .008 (size) (material)
(6) pump 1/2 10 (HP) (yield gpm)
110 AC (type power)
(7) electric log No (yes or no)
(organization running log)
(8) how well bottom plugged


DRILLERS REMARKS:

RECEIVED
JUL 22 1977

MISS. BD. OF WATER COMMISSIONERS

If well telescopes please sketch and show depths.

GROUND LEVEL

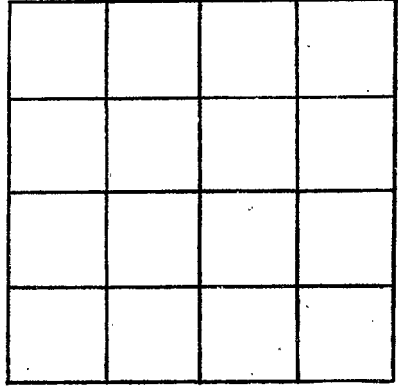

SECTION _____

Please indicate well location X.

ADDITIONAL INFORMATION

If more than one screen, show locations of each on sketch.