

C. P. CLARK

MISSISSIPPI WATER WELL DRILLING
BOARD OF WATER COMMISSIONERS ROUTE 2
416 North State Street AUREL, MISS. 39440
Jackson, Mississippi 39201

Wayne
B 2000
10/14/77

WATER WELL DRILLERS LOG

Wayne

10/14/77
date well completed

C. P. Clark
firm name

county well located


LANDOWNER: <u>W.A.B. Britton</u>	description of formations encountered	from	to
<u>Box 3587 Jackson Miss</u>	<u>Sandy Clay</u>	<u>0</u>	<u>9</u>
<u>(Well near Shalotte Miss)</u>	<u>Sand</u>	<u>9</u>	<u>18</u>
<u>(mailing address)</u>	<u>Clay, Shells & rock Struck</u>	<u>18</u>	<u>390</u>
	<u>Coarse sand</u>	<u>390</u>	<u>397</u>
	<u>Clay</u>	<u>397</u>	<u>420</u>
WELL LOCATION:			
sec. <u>15</u> T. <u>10</u> N. R. <u>8</u> E.			
<u>75±</u> miles <u>NE</u> of <u>Greenville</u>			
(distance) (direction) (nearest town)			
WELL PURPOSE: <u>Home</u>			
(home, irrigation, municipal, industrial)			
WELL COMPLETION DATA:			
(1) diameter (inches) <u>2</u>			
(2) total depth (feet) <u>397</u>			
(3) static water level (feet) <u>30</u> below top of ground.			
(4) casing <u>Galv Iron 392</u>			
(material) (depth)			
(size) If telescope see back.			
(5) screen <u>5</u> <u>392</u>			
(length) (depth to top)			
<u>2</u> <u>Solid S.S. & 006</u>			
(size) (material)			
(6) pump <u>1</u> <u>12</u>			
(HP) (yield gpm)			
<u>240V 7φ</u>			
(type power)			
(7) electric log <u>No</u>			
(yes or no)			
(organization running log)			
(8) how well bottom plugged <u>BWV</u>			
DRILLERS REMARKS: <u>Set 12A</u>			
<u>Get @ 63' New Sta</u>			
<u>Pete Pump & 42 tank</u>			

RECEIVED
OCT 18 1977

MISS. BD. OF WATER COMMISSIONERS

If well telescopes please
sketch and show depths.

GROUND LEVEL

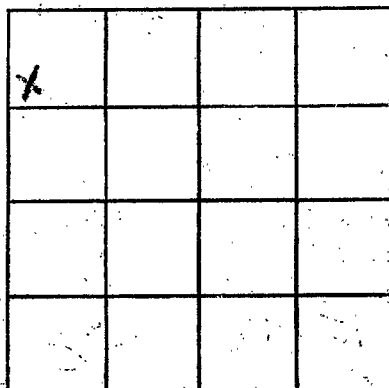

SECTION 15

Please indicate well location X.

ADDITIONAL INFORMATION

If more than one screen,
show locations of each on sketch.