

WAYNE

B 2000

6/7/78

MISSISSIPPI BOARD OF WATER COMMISSIONERS 416 North State Street Jackson, Mississippi 39201

WATER WELL DRILLERS LOG

June 7 1978 Porter Drilling & Log Wayne date well completed firm name county well located

LANDOWNER: Tomlinson Tom

P.O. Box 363

Waynesboro Miss. (mailing address)

WELL LOCATION:

sec 24 T 10 N R 8 E 10 miles NW of Waynesboro (distance) (direction) (nearest town)

WELL PURPOSE: home (home, irrigation, municipal, industrial)

WELL COMPLETION DATA:

- (1) diameter (inches) 2 (2) total depth (feet) 370 (3) static water level (feet) 82 below top of ground. (4) casing P.V.C. 365' (material) (depth) 2' (size) If telescope see back. (5) screen 5' 365' (length) (depth to top) 2' (size) 6 inch S.S. (material) (6) pump 1/2 800 (HP) (yield gpm) elec (type power) (7) electric log no (yes or no)

(organization running log)

(8) how well bottom plugged? by back wash valve

DRILLERS REMARKS:

Table with 3 columns: description of formations encountered, from, to. Rows include: red clay & sand, weathered rock, blue clay, thin rock, blue clay, rock strata, clay, rock & strata, clay, sand & light clay, sand, clay & sand, sand, clay, hard fine sand, soft fine sand, brown clay, stream channel, white shell in soft sand, 102' 1" P.V.C. drop pipe, steel drop above screen.


RECEIVED

JUN 19 1978

MISS. BD. OF WATER COMM.

If well telescopes please sketch and show depths.

GROUND LEVEL

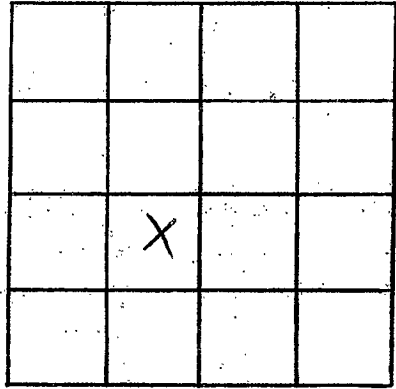

SECTION 24

Please indicate well location X.

ADDITIONAL INFORMATION

more than one screen,
locations of each on sketch.