

WAYNE

B 2003

7-28-78

MISSISSIPPI BOARD OF WATER COMMISSIONERS 416 North State Street Jackson, Mississippi 39201

WATER WELL DRILLERS LOG

July 28 1978 date well completed 78 South Dilling firm name 28 county well located

LANDOWNER: Lynn Betts Rt 1 Shubuta Miss. (mailing address)

Table with 3 columns: description of formations encountered, from, to. Entries include sand & clay, clay, sand, sand & pea gravel, 135' 1/4" galv. pipe.


WELL LOCATION: sec. 13 T 10 N R 8 E S W (distance) miles NE of (direction) (nearest town)

WELL PURPOSE: home (home, irrigation, municipal, industrial)

WELL COMPLETION DATA: (1) diameter (inches) 2" (2) total depth (feet) 147' (3) static water level (feet) 121' below top of ground. (4) casing P.V.C. 142' (material) (depth) 2" (size) if telescope see back. (5) screen 5' 142' (length) (depth to top) 2' (size) bsmt S.S. (material) (6) pump 2 (HP) 6 (yield gpm) elec (type power) (7) electric log no (yes or no) (organization running log)

(8) how well bottom plugged 2" back wash valve


DRILLERS REMARKS:

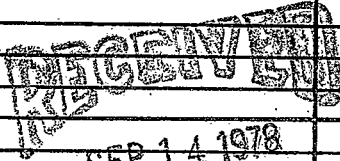

MISS. BD. OF WATER COMMISSIONERS

If well telescopes please sketch and show depths.

GROUND LEVEL

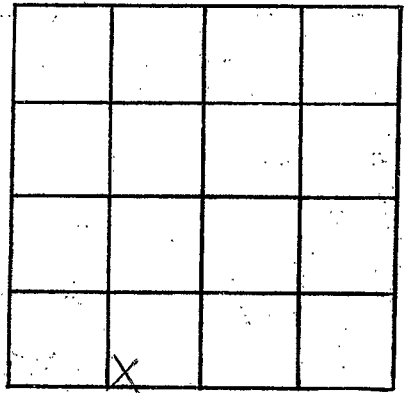

SECTION 13

Please indicate well location X.

ADDITIONAL INFORMATION

If more than one screen,
show locations of each on sketch.