

MISSISSIPPI DEPARTMENT OF NATURAL RESOURCES

Bureau of Land and Water Resources

Southport Mall

P.O. Box 10631

Jackson, Mississippi 39209

WATER WELL DRILLERS LOG

Wayne  
B 2004  
12-9-80

Dec 9 1980 date well completed  
Port Drillers & Inc firm name  
Wayne county well located


| LANDOWNER: <u>Eddie Walker</u>  | description of formations encountered  | from      | to         |
|---|--|-----------|------------|
| <u>Box 1 Hubert, Miss</u><br>(mailing address)  | <u>Clay</u>  | <u>0</u>  | <u>24</u>  |
| WELL LOCATION:<br>sec. <u>35</u> T <u>10</u> N R <u>8</u> E<br><u>8</u> miles <u>NW</u> of <u>Waynesboro</u><br>(distance) (direction) (nearest town)   | <u>clay &amp; clay</u><br><u>sandstone</u><br><u>above</u><br><u>shale &amp; white shell</u><br><u>in sand</u> | <u>24</u> | <u>72</u>  |
| WELL PURPOSE: <u>home</u><br>(home, irrigation, municipal, industrial)  | <u>102' 1" P.V.C</u>   | <u>72</u> | <u>120</u> |
| WELL COMPLETION DATA:<br>(1) diameter (inches) <u>2"</u><br>(2) total depth (feet) <u>120'</u><br>(3) static water level (feet) <u>89'</u> (below/above top of ground)<br>(4) casing <u>P.V.C</u> , <u>115'</u><br>(material) (depth)<br><u>2"</u> if telescope see back.<br>(size)<br>(5) screen <u>5'</u> , <u>115'</u><br>(length) (depth to top)<br><u>2"</u> , <u>bslot S.S.</u><br>(size) (material)<br>(6) pump <u>2</u> , <u>12</u><br>(HP) (yield gpm)<br><u>elec</u><br>(type power)<br>(7) electric log <u>no</u><br>(yes or no)<br>(organization running log)<br>(8) how well bottom plugged<br><u>backwash valve</u> |  |           |            |
| DRILLERS REMARKS:   |  |           |            |

DEPT. OF NATURAL RESOURCES  
BUREAU OF LAND & WATER RESOURCES

JAN 23 1991  
RECEIVED

If well telescopes please sketch and show depths.

GROUND LEVEL

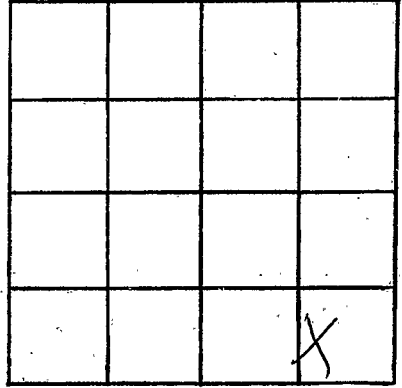

SECTION 35

Please indicate well location X.

ADDITIONAL INFORMATION

If more than one screen,  
show locations of each on sketch.