

MISSISSIPPI DEPARTMENT OF NATURAL RESOURCES

Bureau of Land and Water Resources

Southport Mall

P.O. Box 10631

Jackson, Mississippi 39209

WATER WELL DRILLERS LOG

Wayne  
B 2555  
8-4-81

Aug 4 1981 date well completed  
Porter Drilling & Exp. firm name  
Wayne county well located


LANDOWNER: <u>Ol. Barnett</u> <u>Ol. Shubuta</u>	description of formations encountered	from	to
(mailing address)	<u>red clay</u>	<u>0</u>	<u>12</u>
WELL LOCATION: sec. <u>33</u> T <u>10</u> (N) R <u>8</u> (E) <u>8</u> miles <u>NW</u> of <u>Waynesboro</u> (distance) (direction) (nearest town)	<u>sand</u>	<u>12</u>	<u>60</u>
WELL PURPOSE: <u>home</u> (home, irrigation, municipal, industrial)	<u>open gravel &amp; sand</u>	<u>60</u>	<u>110</u>
WELL COMPLETION DATA: (1) diameter (inches) <u>2"</u>	<u>stagnant white</u>		
(2) total depth (feet) <u>110'</u>	<u>still in sand</u>		
(3) static water level (feet) <u>86'</u> <u>below</u> top of ground.	<u>102' 1" P.V.C. drop pipe</u>		
(4) casing <u>PVC</u> , <u>105'</u> (material) (depth) <u>2'</u> (size) if telescope see back.			
(5) screen <u>5'</u> , <u>105'</u> (length) (depth to top) <u>2"</u> , <u>6 slot S.S.</u> (size) (material)			
(6) pump <u>1/2</u> , <u>8</u> (HP) (yield gpm) <u>elec.</u> (type power)			
(7) electric log <u>no</u> (yes or no)  (organization running log)			
(8) how well bottom plugged <u>2' sand skirt</u>			
DRILLERS REMARKS:			

DEPT. OF NATURAL RESOURCES  
BUREAU OF LAND & WATER RESOURCES

SEP - 9 1981

RECEIVED

If well telescopes please sketch and show depths.

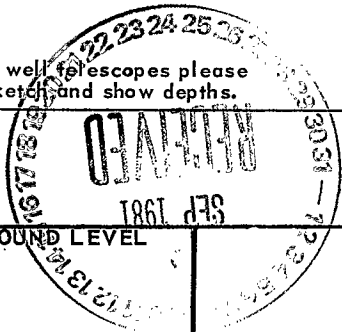

GROUND LEVEL

			X

SECTION 3.3

Please indicate well location X.

ADDITIONAL INFORMATION

If more than one screen, show locations of each on sketch.