

MISSISSIPPI DEPARTMENT OF NATURAL RESOURCES

Bureau of Land and Water Resources

Southport Mall

P.O. Box 10631

Jackson, Mississippi 39209

WATER WELL DRILLERS LOG

Griner Drilling Service, Inc.

Wayne

WAYNE
B 2007

12-5-90
date well completed

firm name

county well located

LANDOWNER:	description of formations encountered	from	to
Columbia Gas Development P.O. Box 1350 Houston, Texas 77251 (mailing address)	rock, clay	0	630
WELL LOCATION: 500'N + 1650'E sec. 18 T. 10 N. R. 8 E of NO. 1 BURNS H.P. (distance) miles (direction) of (nearest town)	Dry Hole		
WELL PURPOSE: (home, irrigation, municipal, industrial)			
WELL COMPLETION DATA:			
(1) diameter (inches)			
(2) total depth (feet) 630'			
(3) static water level (feet) _____ below above top of ground.			
(4) casing (material) _____ (depth) _____ _____ (size) if telescope see back.			
(5) screen (length) _____ (depth to top) _____ _____ (size) _____ (material)			
(6) pump (HP) _____ (yield gpm) _____ _____ (type power)			
(7) electric log (yes or no) _____ _____ (organization running log)			
(8) how well bottom plugged _____			
DRILLERS REMARKS:			


RECEIVED

JAN 16 1991

Dept. of Environmental Quality
Bureau of Land & Water Resources

If well telescopes please sketch and show depths.

GROUND LEVEL

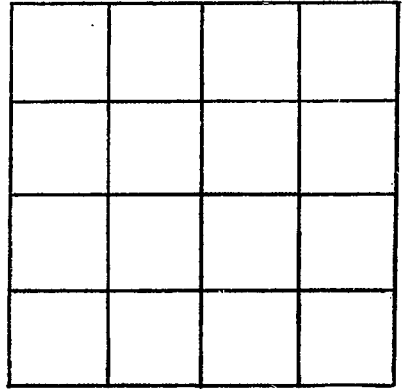

SECTION _____

Please indicate well location X.

ADDITIONAL INFORMATION

If more than one screen,
show locations of each on sketch.