

MISSISSIPPI DEPARTMENT OF ENVIRONMENTAL QUALITY

Office of Land and Water Resources

P. O. Box 10631
Jackson, MS 39289-0631
WATER WELL DRILLERS LOG

COUNTY-WELL LOCATED <u>Wadena</u>	
WELL NUMBER <u>B2008</u>	CODED
DATE WELL COMPLETED <u>8-23-93</u>	

PERMIT NUMBER
NAME OF DRILLING FIRM <u>Ray V. West</u>

NAME & MAILING ADDRESS OF LANDOWNER <u>J. T. Purvis</u>		
WELL LOCATION: SEC <u>32</u> TOWNSHIP <u>10</u> RANGE <u>8</u> <u>N</u> <u>S</u> <u>E</u> <u>W</u>		
DISTANCE <u>3</u> Miles	DIRECTION <u>SE</u>	NEAREST TOWN <u>Fucitta</u>
OTHER LANDMARK		
WELL PURPOSE (Home, Irrigation, Municipal, Industrial, Fish Pond, etc.) <u>Home</u>		

PUMP DATA		
PUMP TYPE (Circle One): <u>Submersible</u> , Turbine, Jet, Flowing Well, Other (Describe)		
POWER TYPE (Circle One): <u>Electric</u> , Tractor, Diesel, Gasoline, Butane, Other (Describe) H/P <u>2</u>		
Pump Capacity (GPM) <u>8</u>	No. of Stages	Setting Depth <u>140</u> FT.
PUMP TEST		
Well yielded _____ GPM with a drawdown of _____ ft. after _____ hours of pumping		

WELL DATA		
Well Depth <u>220</u>	Casing Diameter (In.) <u>4</u>	Casing Length (Ft.) <u>180</u>
Type of Casing <u>PVC</u>	Hole Depth <u>220</u>	Depth to Static Water Level <u>106</u>

LOG DATA	
TYPE OF LOG RUN (Circle One): <u>No Log Run</u> , Electric, Gamma Ray, Density, Sonic, Neutron, Other (Describe)	
Name of Organization Running Log.	

TYPE OF COMPLETION: (Circle One or More): Gravel Packed, Underreamed, Telescoped, Natural Development, <u>Open Hole</u> , Other (Describe) <u>Limestone</u>	
--	--

GEOLOGIC DATA (Office Use Only)			
Surface Elev.	Geologic Unit	Unit Thickness	Depth to Top
Subs. SWL	Date	Analysis	Aquifer Test

WELL GROUTED TO A DEPTH OF <u>15</u> FEET Type Grout (circle one): <u>Cement</u> , Bentonite, or Mix

Driller's Remarks

SCREEN DATA		
Diameter - Inches	Length - Feet	Slot Size - Inches
Screen Type	Depth to Bottom - Feet	


DESCRIPTION OF FORMATIONS ENCOUNTERED	FROM	TO	FORMATIONS (Continued)	FROM	TO
SAND	0	68	<div style="font-size: 2em; font-weight: bold; border: 2px solid black; padding: 5px; display: inline-block;">RECEIVED</div> <div style="font-size: 1.5em; font-weight: bold;">DEC 23 1993</div>		
CLAY	68	130			
SAND	130	150			
CLAY	150	165			
CLAY ROCK STRKS	165	180			
Limestone	180	195			
Limestone CLAY STRK	195	220			

Dept. of Environmental Quality
Office of Land & Water Resources

IF MORE SPACE IS NEEDED, USE BACK

If well telescopes please sketch and show depths.

GROUND LEVEL

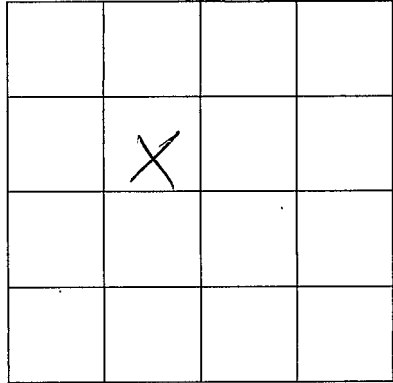

SECTION 32

Please indicate well location X.

ADDITIONAL INFORMATION

If more than one screen,
show location of each on sketch.