

C7

5-19-64

WATER WELL DRILLERS LOG

Date: May 19, 1964, Driller: Porter Drilling & Supply County Wayne  
(Name)

(1) Owner of Land: Gavin Bishop  
(Name)

Box 4 Waynesboro  
(Address)

(2) Location: SE 1/4, NE 1/4, Sec. 21 T10R7

1/2 miles N, of Wivona  
(distance) (direction) (Nearest Town)

(3) Topography: flat  
(Hilly) (Flat) (Level)

(4) Purpose of Well: domestic  
(Domestic Irrigation Municipal, Industrial, Other)

Description & Color of Materials Sand, Clay, Red Clay, Shell, etc.	Thick- ness Feet	Depth Feet
<u>red chalk</u>	<u>24</u>	<u>24</u>
<u>thin rock</u>	<u>24</u>	<u>24</u>
<u>blue chalk</u>	<u>82</u>	<u>106</u>
<u>rock strata</u>	<u>25</u>	<u>131</u>
<u>fine grey sand</u>	<u>4</u>	<u>135</u>
<u>rock</u>	<u>1</u>	<u>136</u>
<u>fine grey sand</u>	<u>9</u>	<u>145</u>

Information upon completion of well:

(1) Diameter 2" inches.

(2) Total Depth 145' feet.

(3) Water Level 25' feet below top of ground.

(4) Cased to 133, Size 2"


(5) Screen: Size 1 1/4", Length 12'  
6' 80 ga  
6' 90 ga

(6) Were any formations sealed against pollution?  
 \_\_\_\_\_ yes, \_\_\_\_\_ no.

If YES depth of formation \_\_\_\_\_

Why \_\_\_\_\_

Drillers Remarks: \_\_\_\_\_

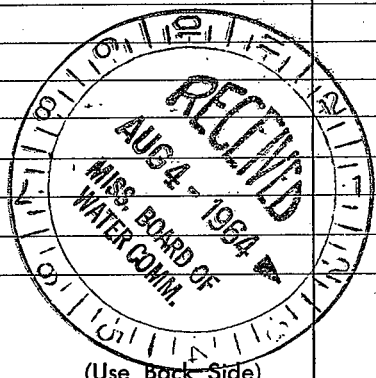

(Use Back Side)

Well No.

1

2

3

4

5

6

7

8

9

10

11