

C8

2-9-62

WATER WELL DRILLERS LOG

Date: Feb 9 31, 1962, Driller: Porter Drilling & Sup. County Wayne

(Name)

(1) Owner of Land: Everett Doggett Jr.
(Name)
At 4 Waynesboro, Miss.
(Address)

(2) Location: SE 1/4, SW 1/4, Sec. 11 T10 R7
3 miles SE. of Shubuta
(distance) (direction) (Nearest Town)

(3) Topography: level
(Hilly) (Flat) (Level)

(4) Purpose of Well: domestic
(Domestic Irrigation
Municipal, Industrial, Other)

Description & Color of Materials Sand, Clay, Red Clay, Shell, etc.	Thick- ness Feet	Depth Feet
stiff clay	10	10
white chalk	20	30
blue chalk	20	50
blue chalk with thin rocks	36	86
blue chalk	69	155
soft rock	7	162
soft chalk & lignite	26	188
sand lignite & chalk	22	210
blue chalk	8	218
sand mixed with lignite	19	237
stop on hard blue chalk		

Information upon completion of well:

(1) Diameter 2" inches.

(2) Total Depth 237' feet.

(3) Water Level 23' feet below top of ground.

(4) Cased to 220', Size 2"


(5) Screen: Size 1 1/4", Length 18'
18' 1 1/4" 80 ga screen

(6) Were any formations sealed against pollution?
yes, X np.

If YES depth of formation _____

Why _____

Drillers Remarks: _____

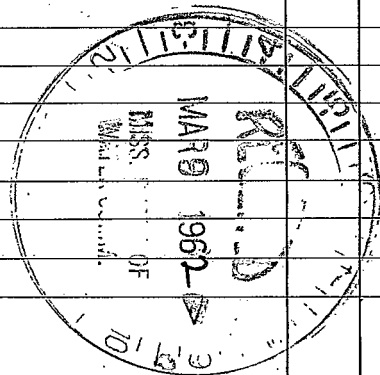

(Use Back Side)

Well No.

