

WAYNE

MISSISSIPPI BOARD OF WATER COMMISSIONERS

C 10

12-16-64

WATER WELL DRILLERS LOG

Date: Dec 16, 1964, Driller: Porter Drilling & Lye County, Wayne

(1) Owner of Land: James Chapman (Name)

At 4 Waplesboro, Miss (Address)

(2) Location: SW 1/4, NW 1/4, Sec. 13 T10R7, 12 miles N of Waplesboro (distance) (direction) (Nearest Town)

(3) Topography: flat (Hilly) (Flat) (Level)

(4) Purpose of Well: Domestic (Domestic Irrigation Municipal, Industrial, Other)

Description & Color of Materials Sand, Clay, Red Clay, Shell, etc.	Thick- ness Feet	Depth Feet
clay	26	26
blue & chalk	73	99
soft rock	2	101
blue chalk	5	106
strata of lime rock	11	117
fine tight sand & chalk	14	131
rock	2	133
blue chalk	57	190
brown chalk & lignite	18	208
chalk lignite & sand	20	228
sand shell & lignite	21	249
stopped while still in sand		

Information upon completion of well:

(1) Diameter 2" inches.

(2) Total Depth 249' feet.

(3) Water Level 58' feet below top of ground.

(4) Cased to 231', Size 2"


(5) Screen: Size 1 1/4", Length 18', 80 ga

(6) Were any formations sealed against pollution? yes, X no.

If YES depth of formation

Why

Drillers Remarks:

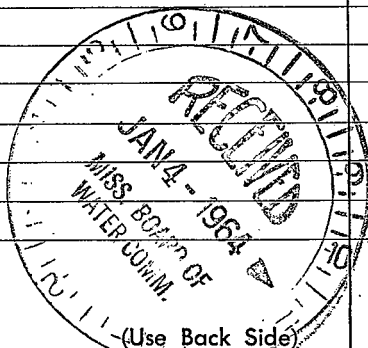

Well No.

