

WAYNE MISSISSIPPI BOARD OF WATER COMMISSIONERS

C11

3-1-65

WATER WELL DRILLERS LOG

Date: ^{3P} March 1, 1965, Driller: Porter Drilling Sup. Co. County Wayne
 (Name)

Lowry well

(1) Owner of Land: Noland Clark
 (Name)
Waynesboro, Miss.
 (Address)

(2) Location: NE 1/4, NE 1/4, Sec 28 T10 R 7
15 miles north of Waynesboro
 (distance) (direction) (Nearest Town)

(3) Topography: hilly
 (Hilly) (Flat) (Level)

(4) Purpose of Well: domestic
 (Domestic Irrigation
 Municipal, Industrial, Other)

Description & Color of Materials Sand, Clay, Red Clay, Shell, etc.	Thick- ness Feet	Depth Feet
<u>chuck</u>	<u>20</u>	<u>20</u>
<u>blue chalk</u>	<u>28</u>	<u>48</u>
<u>thin rock</u>		<u>48</u>
<u>blue chalk</u>	<u>82</u>	<u>130</u>
<u>rock strata</u>	<u>18</u>	<u>148</u>
<u>rock with break</u>	<u>2</u>	<u>150</u>
<u>fine to med sand</u>	<u>12</u>	<u>162</u>
<u>stopped on chally sand</u>		

Information upon completion of well:

(1) Diameter 2" inches.

(2) Total Depth 162' feet.


(3) Water Level 26' feet below top of ground.

(4) Cased to 147', Size 2"
3 1/2" casing screwed into rock

(5) Screen: Size 1/4", Length 12'
80 gr screen

(6) Were any formations sealed against pollution?
 _____ yes, X no.

If YES depth of formation _____
 Why _____
 Drillers Remarks: _____

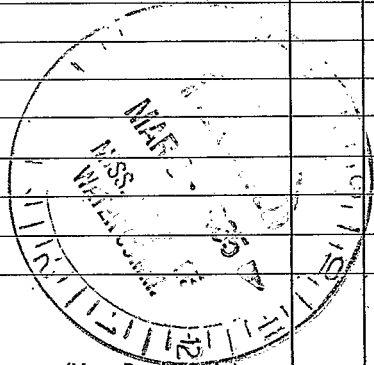

(Use Back Side)

Well No.

