

WAYNE
C12
7-11-66

MISSISSIPPI BOARD OF WATER COMMISSIONERS

3P WATER WELL DRILLERS LOG

Date: July 11, 1966, Driller: Porter Drilling & Co. County: Wayne
(Name)


(1) Owner of Land: Vernon Bishop
(Name)
Rt 4 Magneshoro
(Address)
(2) Location: NE 1/4, NE 1/4, Sec. 28 T1CR 7
1/2 miles N of Kiwano
(distance) (direction) (Nearest Town)
(3) Topography: flat
(Hilly) (Flat) (Level)
(4) Purpose of Well: domestic
(Domestic Irrigation
Municipal, Industrial, Other)

Description & Color of Materials Sand, Clay, Red Clay, Shell, etc.	Thick- ness Feet	Depth Feet
red chalk	26	26
blue chalk	5	31
thin rock		31
blue chalk	79	109
rock strata	23	132
sand	2	134
rock	1	135
sand	2	137
thin rock		137
sand	3	140
rock	1	141
sand	4	145

Information upon completion of well:

(1) Diameter 2" inches.
(2) Total Depth 145' feet.
(3) Water Level 37' feet below top of ground.
(4) Cased to 135', Size 2"
(5) Screen: Size 1/4, Length 12'
80 ga
(6) Were any formations sealed against pollution?
_____ yes, _____ no.

If YES depth of formation _____
Why _____
Drillers Remarks: _____

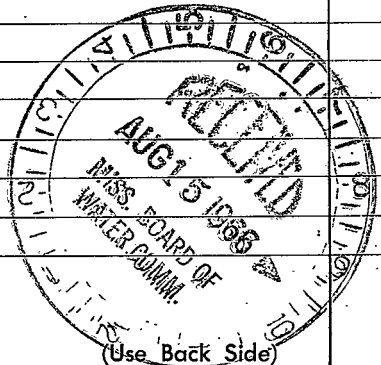

Well No.

