

Wayne
 C14
 12-23-68

MISSISSIPPI
 BOARD OF WATER COMMISSIONERS **CODED**
 416 North State Street
 Jackson, Mississippi 39201

WATER WELL DRILLERS LOG

12-23 1968 Roy West Wayne
 date well completed firm name county well located

LANDOWNER	description of formations encountered	from	to
<u>Lee Pickens</u>	<u>Red clay</u>	<u>8</u>	<u>8</u>
<u>Box 312</u>	<u>Blue clay</u>	<u>8</u>	<u>345</u>
<u>Hivane Miss</u>	<u>Sand</u>	<u>345</u>	<u>363</u>
(mailing address)			

WELL LOCATION:
 sec 27 T 10 N R 2 E
1 miles E of Hivane
 (distance) (direction) (nearest town)

WELL PURPOSE: Home
 (home, irrigation, municipal, industrial)

- WELL COMPLETION DATA:
- (1) diameter (inches) 2
 - (2) total depth (feet) 363
 - (3) static water level (feet) 63 below top of ground.
 - (4) casing Galv 353
 (material) (depth)
 - (size) if telescope see back.
 - (5) screen 10 353
 (length) (depth to top)
1/4 st steel
 (size) (material)
 - (6) pump 1 7
 (HP) (yield gpm)
Rea
 (type power)
 - (7) electric log NO
 (yes or no)

(organization running log)
 (8) how well bottom plugged washed

DRILLERS REMARKS:


CODED

JAN 2 1969

MISS. DEPT. OF WATER RESOURCES

If well telescopes please sketch and show depths.

GROUND LEVEL

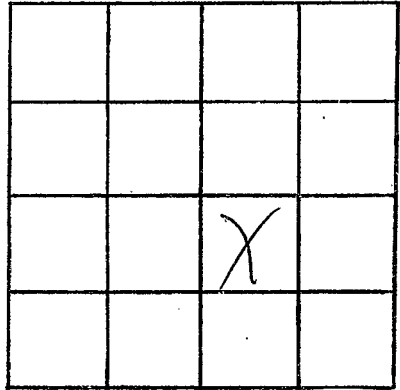

SECTION 27

Please indicate well location X.

ADDITIONAL INFORMATION

If more than one screen,
show locations of each on sketch.