

Wayne  
C 15  
1-22-69

MISSISSIPPI  
BOARD OF WATER COMMISSIONERS  
416 North State Street  
Jackson, Mississippi 39201

CODED

CODED

WATER WELL DRILLERS LOG

Jan 23 19 69 Porte Dalling & Co Wayne  
date well completed firm name county well located

LANDOWNER: Chapman  
Episcopal Church  
Box 4 Waynesboro Miss  
(mailing address)  
WELL LOCATION:  
sec. 13 T 10 N R 7 E  
S W  
11 miles N of Waynesboro  
(distance) (direction) (nearest town)

WELL PURPOSE: Church  
(home, irrigation, municipal, industrial)

WELL COMPLETION DATA:

- (1) diameter (inches) 2"  
(2) total depth (feet) 248  
(3) static water level (feet) 52 below  
top of ground.  
(4) casing steel, 233'  
(material) (depth)  
2"  
(size) If telescope see back.  
(5) screen 11', 236  
(length) (depth to top)  
1 1/2" 80 ga S.S.  
(size) (material)  
(6) pump 3/4, 7  
(HP) (yield gpm)  
elec  
(type power)  
(7) electric log no  
(yes or no)  
(organization running log)  
(8) how well bottom plugged  
filled sand


description of formations encountered	from	to
red chalk	0	18
yellow chalk	18	37
blue chalk	37	79
thin rock		79
blue chalk	79	92
rock chalk transition	92	110
rock & chalk strata	110	132
blue chalk	132	183
chalk light sand	183	194
brown chalk	194	206
fine brown sandstone	206	215
brown chalk	215	232
fine sand / chalk	232	236
coarse sand / a little chalk	236	246
Chalk & sand	246	248
strat white shell in chalk sand		
11' 1/2 80ga S.S. well		
4' 1/2 long bent in		
well packer		
63' 1/2 drag pipe		

FEB 7 1969  
JMS-22-114  
WATER BOARD

DRILLERS REMARKS:

If well telescopes please sketch and show depths.

GROUND LEVEL

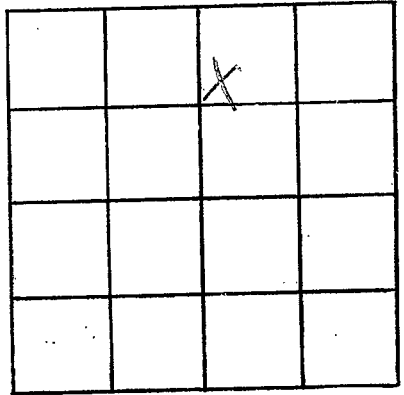

SECTION 13

Please indicate well location X.

ADDITIONAL INFORMATION

If more than one screen,  
show locations of each on sketch.