

Wayne
C16
2-13-69

MISSISSIPPI
BOARD OF WATER COMMISSIONERS
416 North State Street
Jackson, Mississippi 39201

CODED


WATER WELL DRILLERS LOG

Feb. 13 1969 Porta Drillers Log Wayne
date well completed firm name county well located

| LANDOWNER: <u>Clinton Cook</u> | description of formations encountered | from | to |
|--|---|----------------------|-----------------------|
| <u>Minerva Miss</u> (mailing address) | <u>red clay</u> <u>white chalk</u> <u>blue chalk</u> | 0 9 25 | 8 25 50 |
| WELL LOCATION: sec <u>34</u> T <u>10</u> (N) R <u>7</u> (E) <u>8</u> miles <u>N</u> of <u>Minerva</u> (distance) (direction) (nearest town) | <u>blue rock</u> <u>blue chalk</u> <u>rock stratum</u> <u>blue chalk</u> | 50 50 60 70 | 60 70 76 145 |
| WELL PURPOSE: <u>home</u> (home, irrigation, municipal, industrial) | <u>rock stratum cut</u> | 145 | 164 |
| WELL COMPLETION DATA: | <u>extended hole at 164'</u> | | |
| (1) diameter (inches) <u>2"</u> | <u>met hard rock</u> | 164 | 166 |
| (2) total depth (feet) <u>177</u> | <u>cherty sand</u> | 166 | 169 |
| (3) static water level (feet) <u>36</u> (below above top of ground) | <u>clean soft fine sand</u> | 169 | 177 |
| (4) casing <u>steel</u> , <u>165'</u> (material) (depth) | <u>stop on chalk</u> | | |
| <u>2"</u> (size) if telescope see back. | | | |
| (5) screen <u>6'</u> , <u>170</u> (length) (depth to top) | <u>6 1/4" 90 sq S.S. screen</u> | | |
| <u>1 1/2"</u> , <u>80 sq S.S.</u> (size) (material) | <u>with 1" 1/2" pipe below screen and 8 1/2" log</u> | | |
| (6) pump <u>1/2</u> , <u>7</u> (HP) (yield gpm) | <u>pipe on top test</u> | | |
| <u>elec.</u> (type power) | <u>in with packer</u> | | |
| (7) electric log <u>no</u> (yes or no) | | | |
| (organization running log) | | | |
| (8) how well bottom plugged <u>steel plate</u> | | | |
| DRILLERS REMARKS: <u>42' 4" surface casing</u> | MAR 6 1969 MISS. Bd. OF WATER COMMISSIONERS | | |

If well telescopes please sketch and show depths.

GROUND LEVEL

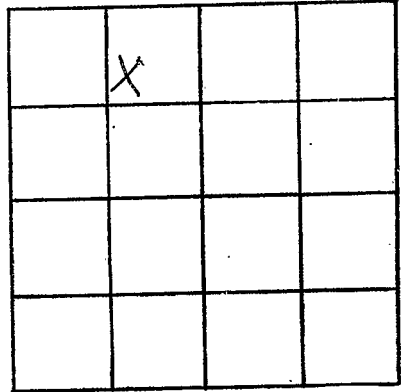

SECTION 34

Please indicate well location X.

ADDITIONAL INFORMATION

If more than one screen, show locations of each on sketch.