

MISSISSIPPI
BOARD OF WATER COMMISSIONERS
416 North State Street
Jackson, Mississippi 39201

CODED

WATER WELL DRILLERS LOG

Wayne
C 17
3-12-69

March 12 19 69 Paul D. Dunnington Wayne
date well completed firm name county well located

LANDOWNER: Clear Creek Baptist Church
Rt 1, Bluebonnet Miss
(mailing address)

description of formations encountered	from	to
<u>rest clay</u>	<u>0</u>	<u>2</u>
<u>red sandstone</u>	<u>2</u>	<u>50</u>
<u>Chalk & Shell</u>	<u>50</u>	<u>65</u>
<u>blue chalk</u>	<u>65</u>	<u>110</u>
<u>limestone rocks</u>	<u>110</u>	<u>129</u>

WELL LOCATION:
sec 31 T N R 7 S W
9 miles NW of Waynesboro
(distance) (direction) (nearest town)

WELL PURPOSE: church
(home, irrigation, municipal, industrial)

WELL COMPLETION DATA:
(1) diameter (inches) 2"
(2) total depth (feet) 129'
(3) static water level (feet) 110' (below) top of ground.
(4) casing steel, 111' (material) (depth)
2" if telescope see back. (size)
(5) screen none (length); (depth to top)
(size) (material)
(6) pump 1/2 (HP) 3 1/2 (yield gpm)
elec. (type power)
(7) electric log no (yes or no)
(organization running log)
(8) how well bottom plugged clay

3 1/2 inch screen at
rock at 110'
CODED


MAR 24 1969

MISS. DEPT. OF
WATER CONTROL

DRILLERS REMARKS:

If well telescopes please sketch and show depths.

GROUND LEVEL

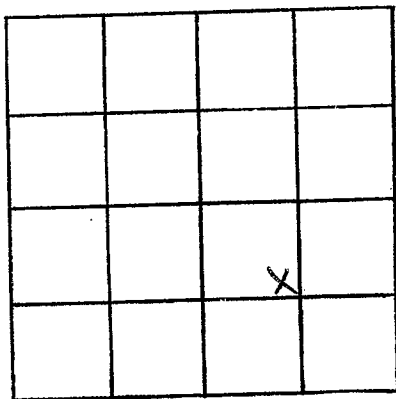

SECTION 31

Please indicate well location X.

ADDITIONAL INFORMATION

If more than one screen,
show locations of each on sketch.