

Wayne
C 18
8-69

MISSISSIPPI
BOARD OF WATER COMMISSIONERS
416 North State Street
Jackson, Mississippi 39201

CODED

CODED

WATER WELL DRILLERS LOG

Aug 1969 Peoples Drilling Co Wayne
date well completed firm name county well located

LANDOWNER: Rabt. Williams
Humane, Miss
(mailing address)

description of formations encountered	from	to
<u>yellow clay</u>	<u>0</u>	<u>15</u>
<u>Blue shale</u>	<u>15</u>	<u>79</u>
<u>Green limestone + limey shale</u>	<u>79</u>	<u>105</u>
<u>Green limey shale</u>	<u>105</u>	<u>150</u>
<u>limestone</u>	<u>150</u>	<u>180</u>
<u>White sand</u>	<u>180</u>	<u>195</u>

WELL LOCATION:
sec. 27 T. 10 N. R. 7 E. W. 3
1 miles E of Humane
(distance) (direction) (nearest town)

WELL PURPOSE: Home
(home, irrigation, municipal, industrial)

WELL COMPLETION DATA:
(1) diameter (inches) 2
(2) total depth (feet) 195
(3) static water level (feet) 124 below top of ground.
(4) casing Galv. 189'
(material) (depth)
2" If telescope see back.
(size)
(5) screen 6' 185'
(length) (depth to top)
2" BRASS
(size) (material)
(6) pump 1 1/2 7
(HP) (yield gpm)
elect
(type power)
(7) electric log no
(yes or no)

(organization running log)
(8) how well bottom plugged BACK
WASH VALVE


DRILLERS REMARKS:

OCT 15 1969

MISS. BD. OF
WATER COMM.

If well telescopes please sketch and show depths.

GROUND LEVEL

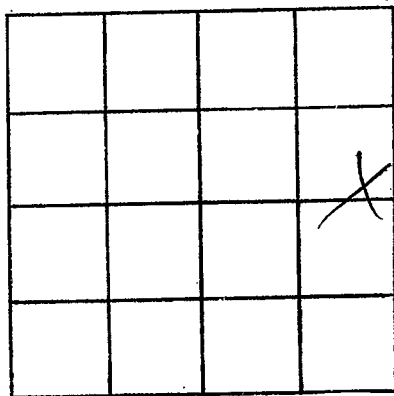

SECTION 27

Please indicate well location X.

ADDITIONAL INFORMATION

If more than one screen, show locations of each on sketch.