

Wayne
C 19
12-10-69

MISSISSIPPI
BOARD OF WATER COMMISSIONERS
416 North State Street
Jackson, Mississippi 39201

CODED

CODED

CODED

WATER WELL DRILLERS LOG

Dec 10 1969 Porter Drilling & Log Wayne
date well completed firm name county well located

LANDOWNER: J. M. Graham
Throumace Miss
(mailing address)
WELL LOCATION:
sec 34 T 10 N R 7 E
1 miles S of Throumace
(distance) (direction) (nearest town)
WELL PURPOSE: home
(home, irrigation, municipal, industrial)

| description of formations encountered | from | to |
|---------------------------------------|------|-----|
| stiff brown chalk | 0 | 10 |
| blue chalk | 10 | 120 |
| rock strata | 120 | 132 |
| sand | 132 | 138 |
| rock strata | 138 | 152 |
| blue chalk | 152 | 210 |
| sand & lignite | 210 | 222 |
| sh. soft rock | | 222 |
| medium shale | | |
| weathered sand | 222 | 227 |
| weathered chalk | 227 | 243 |
| blue chalk | 243 | 253 |
| sand | 253 | 259 |
| blue chalk | 259 | 262 |

WELL COMPLETION DATA:
(1) diameter (inches) 2"
(2) total depth (feet) 262
(3) static water level (feet) flow below above top of ground.
(4) casing steel 222
(material) (depth)
2" if telescope see back.
(size)
(5) screen none
(length) (depth to top)
(size) (material)
(6) pump flow 1 1/2
(HP) (yield gpm)
(type power)
(7) electric log no
(yes or no)
(organization running log)


JAN 12 1970

MISS. BD. OF
WATER COMM.

DRILLERS' REMARKS:

If well telescopes please sketch and show depths.

GROUND LEVEL

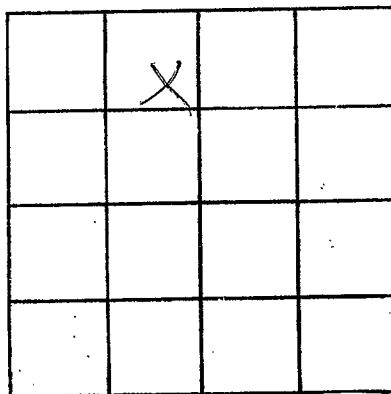

SECTION 34

Please indicate well location X.

ADDITIONAL INFORMATION

If more than one screen, show locations of each on sketch.