

MISSISSIPPI  
BOARD OF WATER COMMISSIONERS  
416 North State Street  
Jackson, Mississippi 39201

**GUIDED**

**WATER WELL DRILLERS LOG**

**WAYNE**  
**C 20**  
**8-5-70**

August 5 1970 Porter Drilling & Supply Wayne  
date well completed firm name county well located

LANDOWNER: Richard Mc. Dill  
211 Shubuta Miss  
(mailing address)

WELL LOCATION:  
sec 18 T N R 7 E  
S 11 miles NW of Waynesboro  
(distance) (direction) (nearest town)

WELL PURPOSE: home  
(home, irrigation, municipal, industrial)

WELL COMPLETION DATA:  
(1) diameter (inches) 2"  
(2) total depth (feet) 326  
(3) static water level (feet) 419 (below/above top of ground)  
(4) casing steel 315  
(material) (depth)  
2" If telescope see back.  
(size)  
(5) screen 12' 314  
(length) (depth to top)  
1 1/4" 20 ga S.S.  
(size) (material)  
(6) pump 1 12  
(HP) (yield gpm)  
elec.  
(type power)  
(7) electric log no  
(yes or no)  
(organization running log)  
(8) how well bottom plugged  
plugged

description of formations encountered	from	to
red clay	0	12
sand	12	35
blue chalk	35	44
blue powder		44
blue chalk	44	164
rock strata	164	176
sand	176	180
rock strata	180	195
blue chalk	195	294
sand	294	326
stop in on chalk		

12' 1/4" 20 ga S.S. with  
1 1/2' 1/4" slip nut in  
well packer  
6 3/4' 1 1/4" large pipe

**COVER**


SEP 9 1970

DRILLERS REMARKS:  
4 1/2' 4" gas the cutoff.  
small water

MISS. BD. OF  
WATER COMM.

If well telescopes please sketch and show depths.

GROUND LEVEL

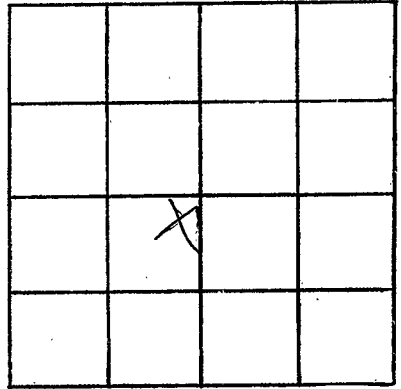

SECTION 18

Please indicate well location X.

ADDITIONAL INFORMATION

If more than one screen,  
show locations of each on sketch.