

WAYNE

C 21

10-16-70

MISSISSIPPI BOARD OF WATER COMMISSIONERS 416 North State Street Jackson, Mississippi 39201

CODED

WATER WELL DRILLERS LOG

Oct 16 1970

date well completed

Ray West Water Wells Wayne

firm name

county well located

LANDOWNER: Dickens

Neuonne Miss

(mailing address)

description of formations encountered

from to

<u>red clay</u>	<u>0</u>	<u>14</u>
<u>Blue clay</u>	<u>14</u>	<u>200</u>
<u>sand</u>	<u>200</u>	<u>215</u>
<u>Blue clay</u>	<u>215</u>	<u>310</u>
<u>sand</u>	<u>310</u>	<u>340</u>

WELL LOCATION:

sec 27 T 10 N R 7 E  
0.1 miles E of Neuonne Miss  
(distance) (direction) (nearest town)

WELL PURPOSE: home  
(home, irrigation, municipal, industrial)

WELL COMPLETION DATA:

- (1) diameter (inches) 2
- (2) total depth (feet) 340
- (3) static water level (feet) 80 below above top of ground.
- (4) casing galv 330  
(material) (depth)

(size) if telescope see back.

- (5) screen 10 330  
(length) (depth to top)  
1/4 stainless  
(size) (material)

- (6) pump 1 7  
(HP) (yield gpm)  
REA  
(type power)

- (7) electric log NO  
(yes or no)

(organization running log)

- (8) how well bottom plugged wash hole

CODED


NOV 4 - 1970

DRILLERS REMARKS:

MISS. BD. OF WATER COMMISSIONERS

If well telescopes please sketch and show depths.

GROUND LEVEL

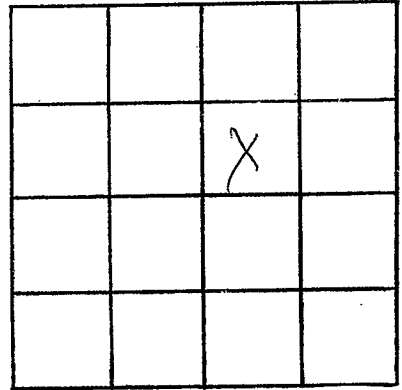

SECTION 27

Please indicate well location X.

ADDITIONAL INFORMATION

If more than one screen,  
show locations of each on sketch.