

WAYNE
C 22
11-4-70

MISSISSIPPI
BOARD OF WATER COMMISSIONERS
416 North State Street
Jackson, Mississippi 39201

CODED

WATER WELL DRILLERS LOG

11/4 1970 Cannewater well serv WAYNE
date well completed firm name county well located

LANDOWNER: James G. Cooper - Rt 4
Waynesboro, Miss
(mailing address)

WELL LOCATION:
sec 10 T10 N R 7 E
1 1/4 miles SE of Shubota
(distance) (direction) (nearest town)

WELL PURPOSE: Home
(home, irrigation, municipal, industrial)

WELL COMPLETION DATA:

(1) diameter (inches) 4" x 2"

(2) total depth (feet) 252

(3) static water level (feet) 90 below above top of ground.

(4) casing Galv 247'
(material) (depth)

(size) if telescope see back.

(5) screen 4' 247'
(length) (depth to top)

2" PLASTIC
(size) (material)

(6) pump 1 5 gal
(HP) (yield gpm)

Elect
(type power)

(7) electric log No
(yes or no)

(organization running log)

(8) how well bottom plugged 2" Brk

description of formations encountered	from	to
Top soil	0	1
Red CLAY	1	5
GRAY + yellow CLAY	5	10
Light Gray Clay	10	30
DARK GRAY CLAY	30	45
yellow CLAY	45	75
Blue CLAY	75	90
yellow CLAY	90	101
white Lime Rock	101	103
Fine GRAY SAND	103	108
white lime Rock	108	109
GRAY SAND	109	115
Blue CLAY	115	122
white lime Rock	122	123
Blue CLAY	123	222
med GRAY SAND	222	233
BROWN CLAY	233	237
med GRAY SAND	237	253
BROWN CLAY	253	258

CODED


NOV 19 1970

MISS. BD. OF
WATER COM.

DRILLERS REMARKS: WAS STILL
IN BROWNISH CLAY WHEN
QUIT

If well telescopes please sketch and show depths.

GROUND LEVEL

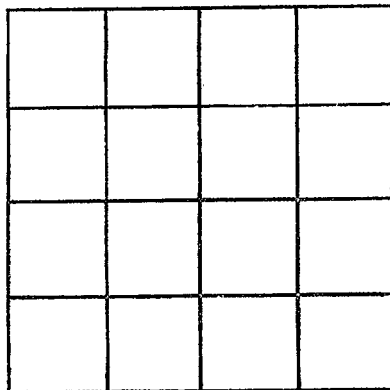

SECTION _____

Please indicate well location X.

ADDITIONAL INFORMATION

If more than one screen,
show locations of each on sketch.