

MISSISSIPPI  
BOARD OF WATER COMMISSIONERS  
416 North State Street  
Jackson, Mississippi 39201

**CODED**

WATER WELL DRILLERS LOG

WAYNE  
C 24  
1-29-71

Jan 29 1971 date well completed  
H. P. Drilling Co. firm name  
Wayne county well located

LANDOWNER: Calvin Stanley  
Shubuta Miss  
(mailing address)

WELL LOCATION:  
sec 26 T 10N R 7E  
S (W)  
1/4 miles east of Shubuta  
(distance) (direction) (nearest town)

WELL PURPOSE: drinking  
(home, irrigation, municipal, industrial)

WELL COMPLETION DATA:  
(1) diameter (inches) 2"  
(2) total depth (feet) 153'  
(3) static water level (feet) 27' (below/above top of ground)  
(4) casing steel 140'  
(material) (depth)  
2" If telescope see back.  
(size)  
(5) screen 12' 141'  
(length) (depth to top)  
1/4" 20 mesh S.S.  
(size) (material)  
(6) pump 1 HP 200  
(HP) (yield gpm)  
elec  
(type power)  
(7) electric log no  
(yes or no)  
(organization running log)

description of formations encountered	from	to
clay	0	15
shaly chert	15	40
rock strata	40	45
blue chert	45	120
rock strata	120	143
red sandstone	143	152
shaly chert	152	155
stop on chert		

12' 20 mesh S.S. well  
5' 1/4" log pipe  
in well packer  
65' 1/4" log pipe

**CODED**


FEB 2 1971

(8) how well bottom plugged plugged  
DRILLERS REMARKS:

MISS. BD. OF  
WATER COMM.

If well telescopes please sketch and show depths.

GROUND LEVEL

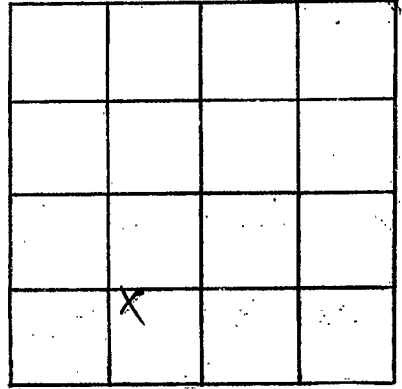

SECTION 26

Please indicate well location X.

ADDITIONAL INFORMATION

If more than one screen,  
show locations of each on sketch.