

WAYNE
C25
4-71

MISSISSIPPI
BOARD OF WATER COMMISSIONERS
416 North State Street
Jackson, Mississippi 39201

CODED

WATER WELL DRILLERS LOG

APRIL 19 71 PEEPLES DRILLING Co WAYNE
date well completed firm name county well located

LANDOWNER: LULA CARVEY
chaney
HIWADDEE, MISS
(mailing address)

WELL LOCATION:
sec 27 T. 10 N S R. 7 E W
1 miles E of Hiwaddie
(distance) (direction) (nearest town)

WELL PURPOSE: HOME
(home, irrigation, municipal, industrial)


- WELL COMPLETION DATA:
- (1) diameter (inches) 2"
 - (2) total depth (feet) 190'
 - (3) static water level (feet) 146' below top of ground.
 - (4) casing GALV (material), 186' (depth), 2" (size) if telescope see back.
 - (5) screen 4' (length), 186' (depth to top), 2" (size), SS (material)
 - (6) pump 3/4 (HP), 3 (yield gpm), ELECTRIC (type power)
 - (7) electric log NO (yes or no)
 - (organization running log)
 - (8) how well bottom plugged BACK WASH VACUE

description of formations encountered	from	to
YELLOW CLAY	0	19
BLUE SHALE	19	63
SHALE & ROCK	63	84
GREEN LIMY SHALE	84	147
LIME & LIMESTONE	147	176
WHITE SAND	176	190
CODED		
MAY 3 - 1971		
MISS. BD. OF WATER COMM.		

DRILLERS REMARKS:

If well telescopes please sketch and show depths.

GROUND LEVEL

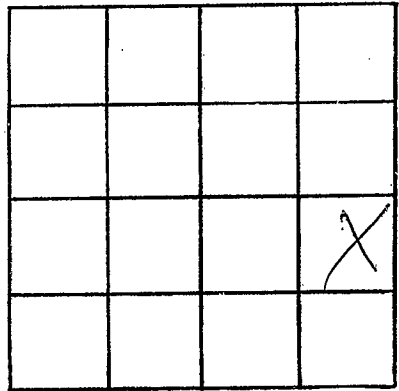

SECTION 27

Please indicate well location X.

ADDITIONAL INFORMATION

If more than one screen,
show locations of each on sketch.