

WAYNE
C26
9-71

MISSISSIPPI
 BOARD OF WATER COMMISSIONERS
 416 North State Street
 Jackson, Mississippi 39201

CODED

WATER WELL DRILLERS LOG

APRIL 1971 PEEPLER DRILLING Co WAYNE
 date well completed firm name county well located

LANDOWNER: EDNA HOLLEY
HiWAHEE, Miss.
 (mailing address)
 WELL LOCATION:
 sec. 27 T. 10 (N) R. 7 (E) (W)
1 miles E of HiWAHEE
 (distance) (direction) (nearest town)

description of fomations encountered	from	to
<u>YELLOW CLAY</u>	<u>0</u>	<u>20</u>
<u>BLUE SHALE</u>	<u>20</u>	<u>63</u>
<u>SHALE + ROCK</u>	<u>63</u>	<u>82</u>
<u>GREEN LIMY SHALE</u>	<u>84</u>	<u>147</u>
<u>LIME + LIMEROCK</u>	<u>147</u>	<u>177</u>
<u>WHITE SAND</u>	<u>177</u>	<u>190</u>

WELL PURPOSE: HOME
 (home, irrigation, municipal, industrial)

WELL COMPLETION DATA:
 (1) diameter (inches) 2"
 (2) total depth (feet) 190
 (3) static water level (feet) 147 below top of ground.
 (4) casing CALU, 186'
 (material) (depth)
2"
 (size) If telescope see back.
 (5) screen 4", 186'
 (length) (depth to top)
2" SS
 (size) (material)
 (6) pump 3/4 3
 (HP) (yield gpm)
ELECTRIC
 (type power)
 (7) electric log no
 (yes or no)
 (organization running log)

(8) how well bottom plugged BACK WASH VACUE

DRILLERS REMARKS:


CODED

MAY 3 - 1971

MISS. BD. OF
 WATER COMMISSIONERS

If well telescopes please sketch and show depths.

GROUND LEVEL

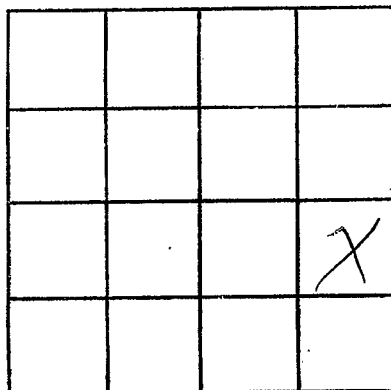

SECTION 27

Please indicate well location X.

ADDITIONAL INFORMATION

If more than one screen,
show locations of each on sketch.