

WATER WELL DRILLERS LOG

CODED

C28
8-29-66

Date: 8/29, 1966 Driller: TERRY
412/27 (Name)

County WAYNE

(1) Owner of Land: BOBBY STANLEY
(Name)

SHUBATA, MISS
(Address)

(2) Location: 1/4, 1/4, Sec. 30 T10R7,
5 miles SW, of SHUBATA,
(distance) (direction) (Nearest Town)

(3) Topography: (Flat)
(Hilly) (Flat) (Level)

(4) Purpose of Well: DOMESTIC
(Domestic Irrigation, Municipal, Industrial, Other)

Description & Color of Materials Sand, Clay, Red Clay, Shell, etc.	Thick- ness Feet	Depth Feet
<u>YELLOW CLAY</u>	<u>25</u>	<u>25</u>
<u>CLAY & LIME</u>	<u>130</u>	<u>155</u>
<u>SAND</u>	<u>20</u>	<u>175</u>
<u>Rock & WHITE clay</u>	<u>75</u>	<u>250</u>
<u>CLAY</u>	<u>60</u>	<u>310</u>
<u>SANDY & Rock</u>	<u>80</u>	<u>390</u>

Information upon completion of well:

(1) Diameter 4 inches.

(2) Total Depth 390 feet.

(3) Water Level 22 feet below top of ground.

(4) Cased to 189', Size 4

(5) Screen: Size NO, Length _____


(6) Were any formations sealed against pollution?
_____ yes, _____ no.

If YES depth of formation _____

Why _____

Drillers Remarks: _____

CODED

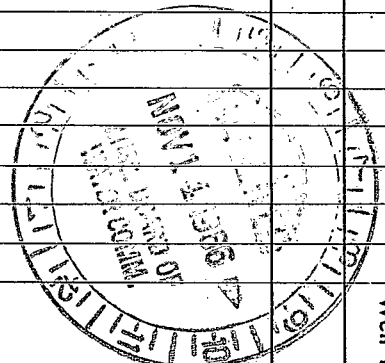

(Use Back Side)

Well No.

