

WATER WELL DRILLERS LOG

**CODED**

C29  
8-30-66

Date: 8/30, 1966 Driller: FERRY County WAYNE  
402 909<sup>403</sup> 905 (Name)

(1) Owner of Land: J. E. McCoy  
(Name)  
SHUBUTA, MISS.  
(Address) 17 10 7

(2) Location: 1/4, 1/4, Sec. 19 T. R  
4 miles SW of SHUBUTA  
(distance) (direction) (Nearest Town)

(3) Topography: (Hilly) (Flat) (Level)

(4) Purpose of Well: DOMESTIC  
(Domestic Irrigation, Municipal, Industrial, Other)

Description & Color of Materials Sand, Clay, Red Clay, Shell, etc.	Thick- ness Feet	Depth Feet
CLAY & SAND	30	30
WHITE CLAY	100	130
WHITE SAND	20	150
SHALE & ROCK	75	225
SANDY	75	300

Information upon completion of well:

(1) Diameter 4 inches.

(2) Total Depth 300 feet.

(3) Water Level flows 6 gpm feet below top of ground.

(4) Cased to 127', Size 4"

(5) Screen: Size NO, Length \_\_\_\_\_


(6) Were any formations sealed against pollution?  
\_\_\_\_\_ yes, \_\_\_\_\_ no.

**CODED**

If YES depth of formation \_\_\_\_\_

Why \_\_\_\_\_

Drillers Remarks: \_\_\_\_\_

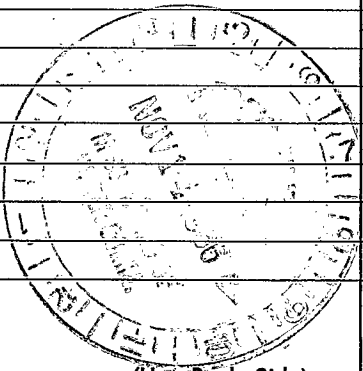

(Use Back Side)

Well No.

