

WAYNE
C.30
5-6-71

MISSISSIPPI
BOARD OF WATER COMMISSIONERS
416 North State Street
Jackson, Mississippi 39201

CODED

WATER WELL DRILLERS LOG

May 6 1971 Porter Drilling Co Wayne
date well completed firm name county well located

LANDOWNER: <u>Van Covington</u>	description of formations encountered	from	to
<u>At 4 Hanesboro Miss</u> (mailing address)	<u>sum. clay shales</u>	0	25
	<u>blue chert</u>	25	53
	<u>thin rocks & blue chert</u>	53	73
	<u>blue chert</u>	73	150
	<u>red shales</u>	150	172
	<u>small fine sand</u>	172	182
	<u>at 1/2 mi. chert</u>		

WELL LOCATION:

sec 34 T 10 N R 7 E
7 miles N of Waynesboro
(distance) (direction) (nearest town)

WELL PURPOSE:

Home
(home, irrigation, municipal, industrial)

WELL COMPLETION DATA:

- (1) diameter (inches) 2"
- (2) total depth (feet) 182
- (3) static water level (feet) 30 below above top of ground
- (4) casing steel 170'
(material) (depth)
2" if telescope see back.
(size)
- (5) screen 10' 172'
(length) (depth to top)
1/2" 80 ga S.S.
(size) (material)
- (6) pump 1 12
(HP) (yield gpm)
elec
(type power)
- (7) electric log none
(yes or no)

(organization running log)

10' 1 1/2" 80 ga S.S. well
4' 1/2" large head in
well packer
63' 1 1/4" large pipe
Francis pump house
Big customer

CODED


JUN 1 1971

MISS. BD. OF
WATER COMMISSIONERS

DRILLERS REMARKS:

If well telescopes please sketch and show depths.

GROUND LEVEL

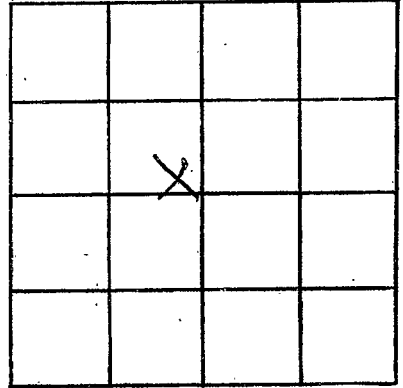

SECTION 34

Please indicate well location X.

ADDITIONAL INFORMATION

If more than one screen, show locations of each on sketch.