

WAYNE
C 31
5-26-71

MISSISSIPPI
BOARD OF WATER COMMISSIONERS
416 North State Street
Jackson, Mississippi 39201

CODED

WATER WELL DRILLERS LOG

Mar 24 1971 Robert D. Miller & Son Wayne
date well completed firm name county well located

LANDOWNER: Emma Roberts
Box 72 Shalabuta Miss.
(mailing address)

WELL LOCATION:
sec. 15 T. 10 N. R. 7 E.
11 miles N of Shalabuta
(distance) (direction) (nearest town)

WELL PURPOSE: Home
(home, irrigation, municipal, industrial)

- WELL COMPLETION DATA:
- (1) diameter (inches) 2"
 - (2) total depth (feet) 241
 - (3) static water level (feet) 50 (below above top of ground)
 - (4) casing steel 217'
(material) (depth)
 - 2"
(size) if telescope see back.
 - (5) screen 12' 229'
(length) (depth to top)
 - 1 1/2" 80 m. S.S.
(size) (material)
 - (6) pump 1 11
(HP) (yield gpm)
 - elec.
(type power)
 - (7) electric log no
(yes or no)
 - (organization running log)
 - (8) how well bottom plugged shut down

description of formations encountered	from	to
red chalk	0	35
blue chalk	35	83
rock strata	83	110
lime sand & chalk	110	120
rock strata	120	135
blue chalk	135	187
red rock	187	189
brown chalk lig.		
1 sand	189	204
sand & chalk	204	229
clean med fine sand	229	241
stop on sandy chalk		
12' 80 ga. S.S. with		
14' 1 1/2" log the top		
with reacher		
6.5' 1 1/4" drop pipe		
water slightly colored		

CODED


JUN 1 1971

MISS. BD. OF
WATER COMM.

DRILLERS REMARKS:

If well telescopes please sketch and show depths.

GROUND LEVEL

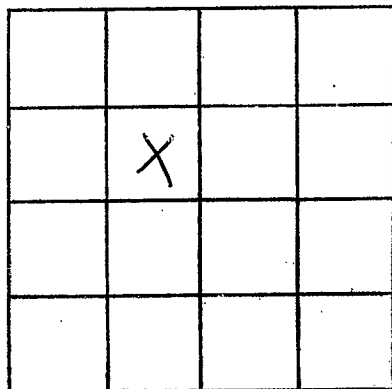

SECTION 15

Please indicate well location X.

ADDITIONAL INFORMATION

If more than one screen, show locations of each on sketch.