

WAYNE
C-32
8-71

MISSISSIPPI
BOARD OF WATER COMMISSIONERS
416 North State Street
Jackson, Mississippi 39201

WATER WELL DRILLERS LOG

CODED

Aug 19 71 Peoples Drilling Co
date well completed firm name
Wayne
county well located

LANDOWNER: Woolie Smith

description of formations encountered

from

to

Hawmore, Miss
(mailing address)

yellow clay

0 22

WELL LOCATION:

sec. 27 T. 10 S. R. 7 W.
1/4 miles E of Hawmore
(distance) (direction) (nearest town)

Blue sand

22 65

WELL PURPOSE: HOME
(home, irrigation, municipal, industrial)

Green shale

65 82

WELL COMPLETION DATA:

(1) diameter (inches) 2
(2) total depth (feet) 315
(3) static water level (feet) 15 ^{below}/_{above} top of ground.

Green limy shale

82 147

(4) casing Galv. 310
(material) (depth)

Light Red & white sand shale

147 161

2 " If telescope see back.
(size)

Blue shale

161 253

(5) screen 5' 310
(length) (depth to top)

Brown Sandy shale

253 274

2 5/8 S.S.
(size) (material)

white sand & brown sandy shale shale

274 315

(6) pump 1 15
(HP) (yield gpm)

GOLDMAN

Electric
(type power)

(7) electric log No
(yes or no)

AUG 15 1971

(organization running log)


(8) how well bottom plugged Reel
Wash barrel

MISS. BD. OF
WATER COM. LOG

DRILLERS REMARKS:

If well telescopes please sketch and show depths.

GROUND LEVEL

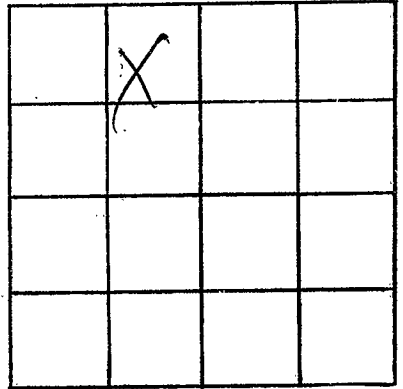

SECTION 27

Please indicate well location X.

ADDITIONAL INFORMATION

If more than one screen, show locations of each on sketch.