

WAYNE

C 33

9-10-71

MISSISSIPPI BOARD OF WATER COMMISSIONERS 416 North State Street Jackson, Mississippi 39201

WATER WELL DRILLERS LOG

CODED

date well completed

firm name

location of well located

LANDOWNER: Campbell (mailing address)

Table with columns: description of formations encountered, from, to. Contains handwritten entries like 'red chert', 'blue chert', 'sand & shale', etc.

WELL LOCATION: sec. 15 T. 100 N. R. 7 E. 11 miles N of (distance) (direction) of (nearest town)

WELL PURPOSE: (home, irrigation, municipal, industrial)

- WELL COMPLETION DATA: (1) diameter (inches) 2", (2) total depth (feet) 211.9, (3) static water level (feet) 55 below top of ground, (4) casing (material) steel (depth) 231', (5) screen (length) 12', (depth to top) 237', (6) pump (HP) 1, (yield gpm) 12, (7) electric log (yes or no)

Continuation of the 'description of formations encountered' table with handwritten entries like '13' 80 gm ss. with', '7' 1 1/2" casing pipe', '6' 1 1/2" casing pipe'.

CODED


OCT 6 1971

DRILLERS REMARKS:

MISS. BD. OF WATER COMM.

If well telescopes please sketch and show depths.

GROUND LEVEL

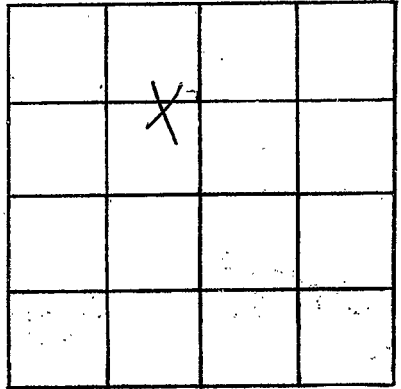

SECTION 15

Please indicate well location X.

ADDITIONAL INFORMATION

If more than one screen, show locations of each on sketch.