

WAYNE
C 34
8-30-71

MISSISSIPPI
BOARD OF WATER COMMISSIONERS
416 North State Street
Jackson, Mississippi 39201

CODED

WATER WELL DRILLERS LOG

Aug 30 1971 Royl West Water Well Wayne
date well completed firm name county well located


LANDOWNER: William
H. Lopez
Waynesboro Pt 4
(mailing address)

| description of formations encountered | from | to |
|---------------------------------------|------|-----|
| Clay | 0 | 10 |
| Blue Clay | 10 | 110 |
| fine sand | 110 | 120 |
| Clay | 120 | 130 |
| Sand | 220 | 240 |

WELL LOCATION:
sec. 10 T. 10 N R. 7 E
2 miles S of Shubert
(distance) (direction) (nearest town)

WELL PURPOSE: home
(home, irrigation, municipal, industrial)

- WELL COMPLETION DATA:
- (1) diameter (inches) 2
 - (2) total depth (feet) 240
 - (3) static water level (feet) 68 below top of ground.
 - (4) casing galv. 235
(material) (depth)
 - (size) if telescope see back.
 - (5) screen 5ft 235
(length) (depth to top)
 - 1 1/2 St steel
(size) (material)
 - (6) pump 1 8
(HP) (yield gpm)
 - REA
(type power)
 - (7) electric log no
(yes or no)
 - (organization running log)
 - (8) how well bottom plugged washwater

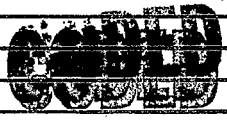


OCT 16 1971

DRILLERS REMARKS:

MISS. BD. OF
WATER COMM.

If well telescopes please sketch and show depths.

GROUND LEVEL

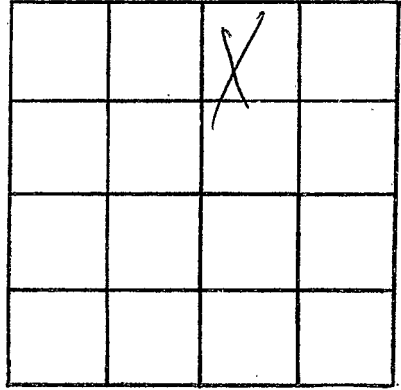

SECTION 10

Please indicate well location X.

ADDITIONAL INFORMATION

A series of horizontal lines for additional information, consisting of 18 lines.

If more than one screen, show locations of each on sketch.