

Wayne
C 36
11-71

MISSISSIPPI
BOARD OF WATER COMMISSION
416 North State Street
Jackson, Mississippi 39201

CODED

MISS. BD. OF
WATER COMM

WATER WELL DRILLERS LOG

Nov. 19 71 date well completed
Peoples Drilling Co. firm name
Wayne county well located

LANDOWNER: Baitha Chapman

description of formations encountered

from to

Yellow clay 0 22

Hawance, Miss
(mailing address)

Blue clay 22 84

WELL LOCATION:

sec. 27T-10N R. 7E
1/4 miles N of Hawance
(distance) (direction) (nearest town)

Green limy clay + Rock streaks 84 115

limestone Rock + fine sand 115 135

WELL PURPOSE: Home
(home, irrigation, municipal, industrial)

Gray shale 135 233

WELL COMPLETION DATA:

Brown sandy shale 233 272

(1) diameter (inches) 2
(2) total depth (feet) 300
(3) static water level (feet) 5 below top of ground. above

White sand 272 300

(4) casing Galv. 294'
(material) (depth)
2"
(size) if telescope see back.

CODED

(5) screen 6' 294'
(length) (depth to top)
2 5/8" SS
(size) (material)

(6) pump 1/2 12
(HP) (yield gpm)
electric
(type power)

(7) electric log no
(yes or no)


(organization running log)

(8) how well bottom plugged Back
wash valve

DRILLERS REMARKS:

If well telescopes please sketch and show depths.

GROUND LEVEL

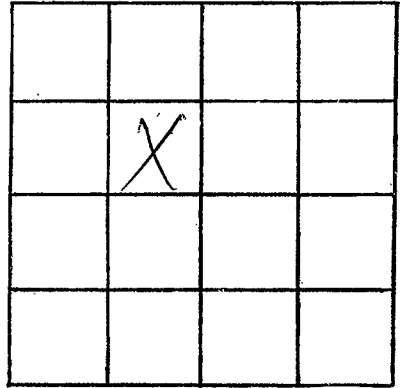

SECTION 27

Please indicate well location X.

ADDITIONAL INFORMATION

If more than one screen, show locations of each on sketch.