

WAYNE
C40
6-29-72

MISSISSIPPI
 BOARD OF WATER COMMISSIONERS
 416 North State Street
 Jackson, Mississippi 39201

CODED

WATER WELL DRILLERS LOG

June 29 1972 *Porter Drilling & Sump* *Wayne*
 date well completed firm name county well located

LANDOWNER: *Fred Hendley*
P.O. Box 492
Shubuta Miss
 (mailing address)

WELL LOCATION:
 sec 15 T 10 N R 7 E
2 miles S of *Shubuta*
 (distance) (direction) (nearest town)

WELL PURPOSE: *home*
 (home, irrigation, municipal, industrial)

WELL COMPLETION DATA:
 (1) diameter (inches) 2"
 (2) total depth (feet) 233
 (3) static water level (feet) 71 (below above top of ground.)
 (4) casing steel 222
(material) (depth)
2' if telescope see back.
(size)
 (5) screen 9' 224
(length) (depth to top)
1 1/4" 3' 80 gss 6' 60 gss
(size) (material)
 (6) pump 1 8 1/2
(HP) (yield gpm)
also
(type power)
 (7) electric log no
(yes or no)
 (organization running log)

description of formations encountered	from	to
<i>red chalk</i>	<i>0</i>	<i>27</i>
<i>grey chalk</i>	<i>27</i>	<i>71</i>
<i>rough strata</i>	<i>71</i>	<i>118</i>
<i>chalk</i>	<i>118</i>	<i>126</i>
<i>chalk</i>	<i>126</i>	<i>127</i>
<i>chalk</i>	<i>127</i>	<i>131</i>
<i>rock shubuta</i>	<i>131</i>	<i>147</i>
<i>gn. chalk</i>	<i>147</i>	<i>189</i>
<i>1st fl. rock</i>	<i>189</i>	<i>190</i>
<i>gn. chalk</i>	<i>190</i>	<i>200</i>
<i>rock</i>	<i>200</i>	<i>203</i>
<i>hard chalk shell</i>	<i>203</i>	<i>213</i>
<i>chalk</i>	<i>213</i>	<i>219</i>
<i>sample & chalk</i>	<i>219</i>	<i>233</i>
<i>stop on chalk streaks</i>		
<i>84' 1 1/4" deep pipe</i>		
<i>3' 80 gss</i>		
<i>6' 60 gss</i>		
<i>5' 1 1/4" deep pipe</i>		
<i>with gravel</i>		

CODED


JUN 29 1972

WATER LOG

(8) how well bottom plugged
flush point
 DRILLERS REMARKS:

If well telescopes please sketch and show depths.

GROUND LEVEL

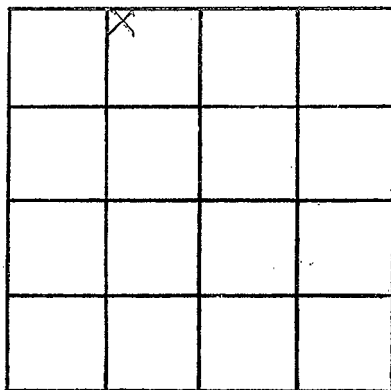

SECTION 15

Please indicate well location X.

ADDITIONAL INFORMATION

If more than one screen, show locations of each on sketch.