

WAYNE

C 42

8-22-73

MISSISSIPPI
 BOARD OF WATER COMMISSIONERS
 416 North State Street
 Jackson, Mississippi 39201

SEP 22 1973

WATER WELL DRILLERS LOG

MISS. BD. OF

WATER COM.

Aug 22 1973
date well completed

Booth Drilling & Log
firm name

Worcester
county well located

LANDOWNER: Mrs. Homer Conway

description of formations encountered

from

to

Thurane Mine
(mailing address)

red clay	0	10
Course sand	10	20
blue chalk	20	26
rock strata	26	60
blue chalk	60	138
rock strata	138	161
fine sand	161	168
chalk	168	172
rock	172	173
chalk	173	175

WELL LOCATION:

sec 34 T 10 N R 7 E
 S W
 1 miles south of Thurane
 (distance) (direction) (nearest town)

WELL PURPOSE: home
(home, irrigation, municipal, industrial)

WELL COMPLETION DATA:

- (1) diameter (inches) 2'
 - (2) total depth (feet) 175'
 - (3) static water level (feet) 21' below top of ground
 - (4) casing steel, 159' (material) (depth)
2' (size) if telescope see back.
 - (5) screen 5' 163' (length) (depth to top)
1/4" galv SS. (size) (material)
 - (6) pump 1 10 (HP) (yield gpm)
elec. (type power)
 - (7) electric log no (yes or no)
- (organization running log)


6' 1/4" log pipe above
 5' 1/4" galv SS. well
 7 1/2' 1/4" steel pipe
 below screen & well
 in with grader
 84' 1/4" drop pipe

(8) how well bottom plugged
mud plug

DRILLERS REMARKS:

If well telescopes please sketch and show depths.

GROUND LEVEL

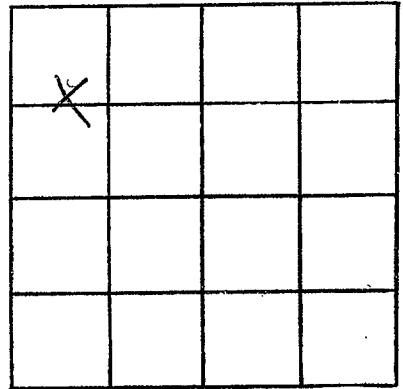

SECTION 34

Please indicate well location X.

ADDITIONAL INFORMATION

If more than one screen,
show locations of each on sketch.