

BOARD OF WATER COMMISSIONERS

416 North State Street
Jackson, Mississippi 39201

WAYNE

C 43

12-6-73

WATER WELL DRILLERS LOG

Dec 6 1973 Porter Drilling & Log Wayne
date well completed firm name county well located

LANDOWNER: Odell Nelson

description of formations encountered	from	to
---------------------------------------	------	----

Shubuta Miss
(mailing address)

rest chalk	0	30
blue chalk	30	94
rock strata	94	117
sand + shells	117	129
rock strata	129	140
blue chalk	140	196
soft rock	196	199
sand chalk lime	199	230
sand some shells	230	239
clean wet sand	239	245
stop on chalk		

WELL LOCATION:
sec 10 T 10 (N) R 7 (E)
2 miles S of Shubuta
(distance) (direction) (nearest town)

WELL PURPOSE: home
(home, irrigation, municipal, industrial)

WELL COMPLETION DATA:

- (1) diameter (inches) 2"
 - (2) total depth (feet) 245'
 - (3) static water level (feet) 80 below top of ground. above
 - (4) casing steel, 233'
(material) (depth)
2" if telescope see back.
(size)
 - (5) screen 5', 240'
(length) (depth to top)
1 1/4", 6 slot SS.
(size) (material)
 - (6) pump 1, 9
(HP) (yield gpm)
elec
(type power)
 - (7) electric log no
(yes or no)
- (organization running log)
- (8) how well bottom plugged
plugged

5' 1 1/4" 6 slot SS with
8' 1 1/4" lay pipe
in with pack
97' 1 1/4" drop pipe

CODED


DEC 12 1973

DRILLERS REMARKS:

Mississippi State Board of Water Commissioners

If well telescopes please sketch and show depths.

GROUND LEVEL

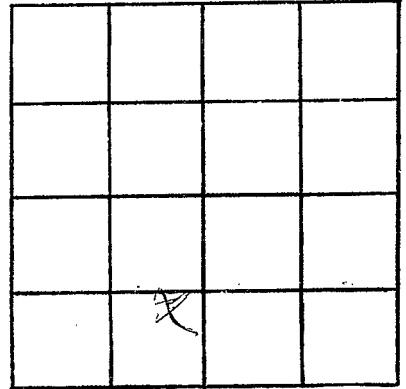

SECTION 10

Please indicate well location X.

ADDITIONAL INFORMATION

If more than one screen,
show locations of each on sketch.