

BOARD OF WATER COMMISSIONERS

416 North State Street

Jackson, Mississippi 39201

WAYNE

C 44

11-7-73

WATER WELL DRILLERS LOG

Nov 7 1973 date well completed 233 Route A firm name Wayne county well located

LANDOWNER: Insurance  
Bay Street Church  
Insurance Miss.  
(mailing address)

description of formations encountered	from	to
brown chalk	0	24
blue chalk	24	131
red shales	131	154
sand cover	154	165
Topsoil Chalk		

WELL LOCATION:  
sec 28 T 10 N R 7 E  
9 miles N of Waynesboro  
(distance) (direction) (nearest town)

WELL PURPOSE: Church  
(home, irrigation, municipal, industrial)

WELL COMPLETION DATA:

- (1) diameter (inches) 2"
- (2) total depth (feet) 165'
- (3) static water level (feet) 30' (below above top of ground)
- (4) casing: steel, 151' (material) (depth)  
2" (size) if telescope see back.
- (5) screen 10' (length) 155' (depth to top)  
1 1/2" (size) 80 gm brass pack (material)
- (6) pump 1 (HP) 12 (yield gpm)  
elec (type power)
- (7) electric log no (yes or no)
- (organization running log)
- (8) how well bottom plugged flush ground

10' 80 gm brass pack screen with 6' 1 1/2" pipe pipe joint with packer

65' 1 1/2" long pipe


CODED

DRILLERS REMARKS:

NOV 12 1973

If well telescopes please  
sketch and show depths.

GROUND LEVEL

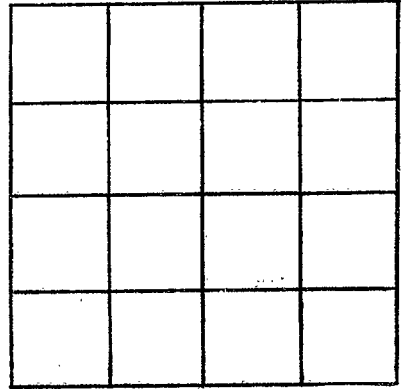

SECTION \_\_\_\_\_

Please indicate well location X.

ADDITIONAL INFORMATION

If more than one screen,  
show locations of each on sketch.